

CHILLER ROOM

MAKE-UP TANK

EXPANSION TANK


PRESSURE BOOSTER PUMPS

COOLING TOWERS

PIPINGS COLOUR BRAND / CODE
 BRAND :- JOTUN
 CODE :- CHILLED WATER SUPPLY - G670
 CHILLED WATER RETURN - G629
 CONDENSER SUPPLY - G268
 CONDENSER RETRUN - G274

LEGEND

- FLEXIBLE CONNECTION
- CHECK VALVE
- BUTTERFLY VALVE
- MOTORISED VALVE
- EXPANDER
- TEST PLUG
- 2-WAY ELECTROMAGNETIC ON/OFF VALVE
- BALANCING VALVE
- STRAINER
- GATE VALVE
- FLOW SWITCH
- FAN COIL UNIT
- CONDENSATE DRAIN PIPE c/w INSULATION
- 2-WAY MODULATING VALVE
- PUMP

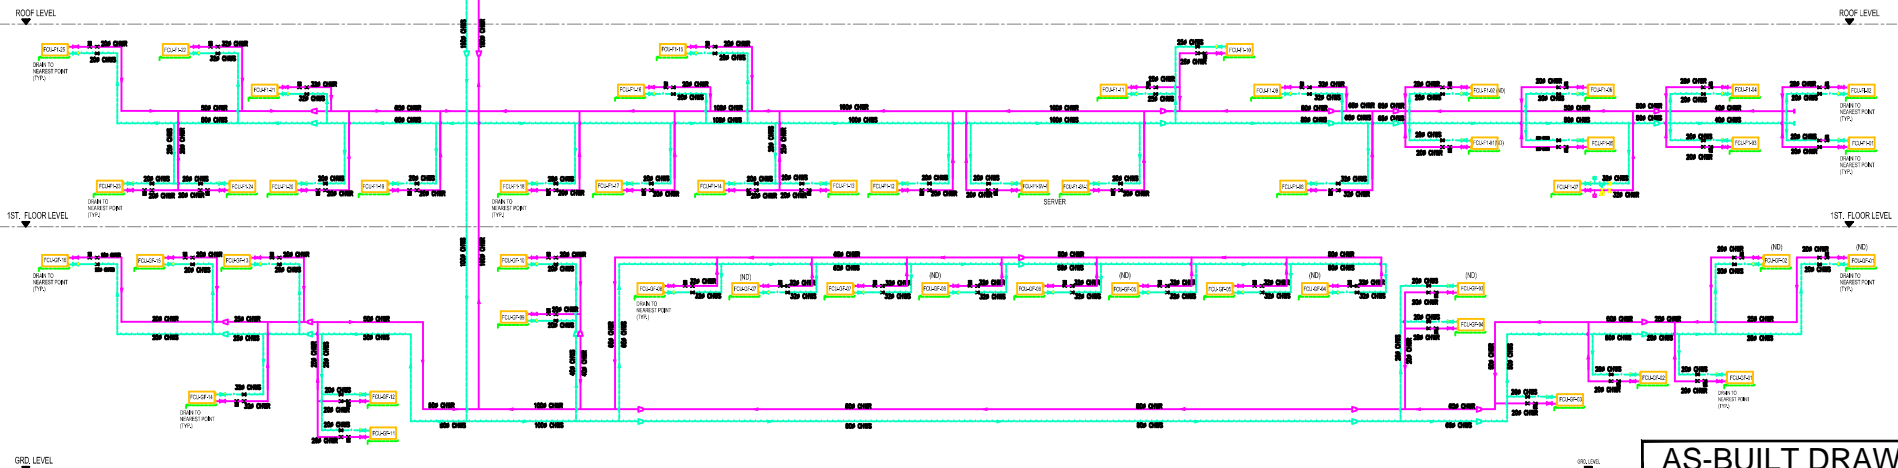

AS-BUILT DRAWING

<p>NOTICE</p> <p>This drawing and all information thereon is the property of EVAS engineering services sdn. bhd. No.14 & 15, Jalan Sepuluh ASB/A, Taman Perindustrian Axis, Selangor 40150 Shah Alam, Selangor Darul Ehsan. Tel :- 03-61968218 Fax :- 03-61968219/20</p> <p>This drawing and all information thereon is confidential and must not be made public, copied or used to disadvantage EVAS engineering services sdn. bhd. It is subject to return on demand.</p>	<p>Owner :</p> <p>RHB TRUSTEES BERHAD (AS TRUSTEE FOR AXIS REIT) LEVEL11, TOWER ONE, RHB CENTRE, JALAN TUN RAZAK 50400 KUALA LUMPUR</p>	<p>Architect:</p> <p>KOOI KEAT ARCHITECT No.10, Jalan Bukit Gasing, 11800 Penang, Malaysia. Tel: 04-669 9907 Fax: 04-666 9976 e-mail: kooi.keat@kooiarchitect.com.my</p>	<p>M&E Consulting Engineers :</p> <p>HAN YANG CONSULTANCY SDN BHD MECHANICAL & ELECTRICAL CONSULTING ENGINEERS 12-8, Medan Angkasa 2, 11900 Bandar Baru Ayer Itam, Pulau Pinang. Tel: 04-6294488 Fax: 04-6322288 E-mail: hanyang.sdn.bhd@gmail.com</p>	<p>Main Contractor :</p> <p>AME ---CONSULTANT ON--- AME CONSTRUCTION SDN BHD NO.18, JALAN ANGGASA MAS 5, KOMPLEKS PERKAWASAN TERBUKA 2 81100 JOHOR BARU, JOHOR. TEL: 07-3555 111 FAX: 07-3541 646 EMAIL: info@ameconstruction.com.my WEBSITE: www.ameconstruction.com.my</p>	<p>Air-Conditioning Contractor :</p> <p>EVAS engineering services sdn. bhd. No.14 & 15, Jalan Sepuluh ASB/A, Taman Perindustrian Axis, Selangor 40150 Shah Alam, Selangor. Tel :- 03-61968218 Fax :- 03-61968219/20 Email: evasengineering@evas.com.my hwa1979@gmail.com</p>	<p>Project Name :</p> <p>CADANGAN PEMBANGUNAN MEMBINA GUDANG MERANGKUMU :- 1. FASA 1 - GUDANG 1 TINGKAT (120m X 360m) DENGAN PEJABAT / BLOK SOSIAL 2. TRINGKAT BERTUA SEBILAH PENCAHANG ELEKTRIK, 3 UNIT PONDOK PENGAJAWAL, 1 UNIT TEMPAT PEMBUANGAN SAMPAH, 1 UNIT WASTE TREATMENT TANK, 1 UNIT RUMAH PAUK.</p> <p>DIATAS LOT 7316 (P.T. 3409) JALAN KLANG - BANTING, MUKIM TELUK PANGLIKA GABANG, DAERAH KUALA LANGKAT, SELANGOR DARUL EHSAN.</p> <p>UNTUK TETAPAN: RHB TRUSTEES BERHAD, (AS TRUSTEE FOR AXIS REAL ESTATE INVESTMENT TRUST)</p>	<p>Subject :</p> <p>CHILLED WATER & CONDENSER WATER PIPINGS SCHEMATIC</p> <p>Checked By : Charlie Designed By : Charlie Drawn By : Siti Date : 18/01/18 Job Ref : 004-2018-NDC Scale : N.T.S (A1) Drawing No : HRS/AXIS/MDC/004/11/16-SCS.1(ABD)</p>
---	---	--	--	---	---	---	--