


MECHANICAL FAN SCHEDULE

FAN TAG NO.	FAN MODEL (KRUGER)	TYPE	FAN DIAMETER	CAPACITY (CFM)	STATIC PRESSURE		MOTOR		DIMENSION - MM (HxWxD)	WEIGHT (KG)	CONTROL PANEL TAG
					(inch WG)		KW	PHASE			
EAF-MHE-1	CFT500 c/w FDA500C	Cab CIL	500	11,910	1		5.5	3	1,225 x 1,600 x 1,568	375	CP-EAF-MHE-1&2
EAF-MHE-2	CFT500 c/w FDA500C	Cab CIL	500	11,910	1		5.5	3	1,225 x 1,600 x 1,568	375	

REMARKS :-  
 1) EXHAUST DUCT SHALL BE 12MM THICKNESS GALV. IRON.  
 2) CONTROL PANEL TO COMPLETE WITH 7 DAYS TIMER

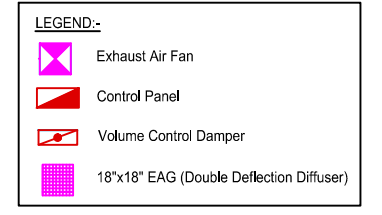

# AS-BUILT DRAWING

**NOTICE**  
 This drawing and all information thereon is the property of HVAR engineering services sdn. bhd. No.5A & 5B, Jalan Sepadu A25/A, Taman Perindustrian Axis, Seksyen 25, 40400 Shah Alam, Selangor Darul Ehsan. Tel :- 03-51248218 Fax :- 03-51248219/20  
 This drawing and all information thereon is confidential and must not be made public, copied or used to disadvantage HVAR engineering services sdn. bhd. It is subject to return on demand.

**Owner :**  
**RHB TRUSTEES BERHAD**  
 (AS TRUSTEE FOR AXIS REIT)  
 LEVEL 11, TOWER ONE,  
 RHB CENTRE, JALAN TUN RAZAK  
 50400 KUALA LUMPUR

**Architect:**  
**KOO I KEAT ARCHITECT**  
 no.19, taman bukit d'ambur, 11800 penang, malaysia.  
 tel : 04-659 9987 fax : 04-656 8478 e-mail : kooikeat@kooikeatarchitect.com.my

**M&E Consulting Engineers :**  
**HAN YANG CONSULTANCY SDN BHD**  
 MECHANICAL & ELECTRICAL CONSULTING ENGINEERS  
 12-B, Medan Angsana 2,  
 11500 Bandar Baru Ayer Itam,  
 Pulau Pinang.  
 Tel: 04-8294489 Fax: 04-8292289  
 E-mail : hanyang.sdn.bhd@gmail.com

**Main Contractor :**  
**AME CONSTRUCTION**  
 AME CONSTRUCTION SDN BHD  
 NO. 18, JALAN ANGKASA MAS 6  
 KAWASAN PERINDUSTRIAN TEBRAU 2  
 81100 JOHOR BAHRU, JOHOR  
 TEL : 07-3555 111 FAX : 07-3541 648  
 EMAIL : info@ameconstruction.com.my  
 WEBSITE : www.ameconstruction.com.my

**Air-Conditioning Contractor :**  
**HVAR engineering services sdn. bhd.**  
 No.5A & 5B, Jalan Sepadu A25/A,  
 Taman Perindustrian Axis, Seksyen  
 25, 40400 Shah Alam, Selangor.  
 Tel :- 03-51248218  
 Fax :- 03-51248219/20  
 Email: hvarengineering@yahoo.com  
 hvair1979@gmail.com

**Project Name :**  
 CADANGAN PEMBANGUNAN MEMBINA GUDANG MERANGKUMI :-  
 1. FASA 1 - GUDANG 1 TINGKAT ( 120m X 360m )  
 DENGAN PEJABAT / BLOK SOSIAL  
 2. TINGKAT SERTA SEBUAH PENCAWANG  
 ELEKTRIK, 3 UNIT PONDOK PENGAWAL,  
 1 UNIT TEMPAT PEMBUANGAN SAMPAH,  
 1 UNIT WASTE TREATMENT TANK, 1 UNIT  
 RUMAH PAM.  
 DIATAS LOT 7314 ( P.T. 3609 )  
 JALAN KLANG - BANTING, MUKIM TELUK PANGLIMA  
 GARANG, DAERAH KUALA LANGAT,  
 SELANGOR DARUL EHSAN.  
 UNTUK TETUAN : RHB TRUSTEES BERHAD,  
 (AS TRUSTEE FOR AXIS REAL ESTATE INVESTMENT TRUST)

**Subject :**  
**MECHANICAL EXHAUST SYSTEM & SWITCHBOARD, CONTROL & POWER CIRCUIT - MHE ROOM**  
**Checked By :** Charlie  
**Designed By :** Charlie  
**Drawn By :** Siti/Pija  
**Date :** 15/01/18 **Job Ref :** 094-2016-NDC  
**Scale :** 1:100 (A1)  
**Drawing No :** HES/AXIS/NDC/094/09/16-AC.MV (ABD)