



PLAN VIEW

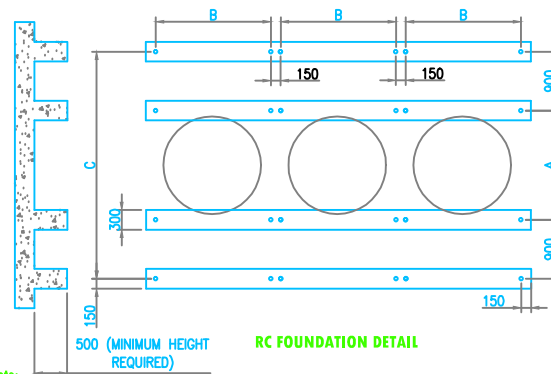


RC FOUNDATION DETAIL


Note:
Height shown is for reference only. Actual height required need to be determined at site by others.

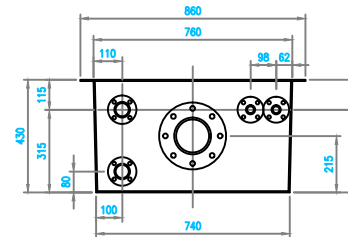

WATER SUMP DETAIL

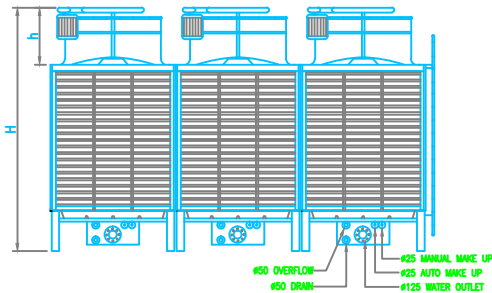

FRONT VIEW

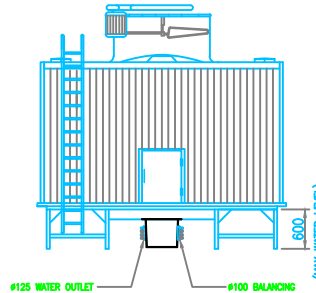

SIDE VIEW

MODEL	Ø FAN	MOTOR (kw) x QTY.	TOWER DIMENSION				FOUNDATION DETAILS			PIPING SIZE (Dia)						WEIGHT (kg)	
			L	W	h	H	A	B	C	WATER INLET	WATER OUTLET	OVERFLOW	DRAIN	MANUAL MAKE UP	AUTO MAKE UP	DRY WEIGHT	OPERATING WEIGHT
GPC 150 x 3 units	Ø1500	3.7 X 3	5730	3700	880	3720	1670	1760	3470	100 X 6	125 X 3	50 X 3	50 X 3	25 X 3	25 X 3	3750	7890

AS-BUILT DRAWING

<p>NOTICE</p> <p>This drawing and all information thereon is the property of RYAB engineering services sdn. bhd.</p> <p>No.11 & 12, Jalan Sepadu 1/55/A, Taman Perindustrian Aca, Seksyen 20, 40400 Shah Alam, Selangor Darul Ehsan.</p> <p>Tel :- 03-51048518 Fax :- 03-51048519/20</p> <p>This drawing and all information thereon is confidential and must not be made public, copied or used to disassemble RYAB engineering services sdn. bhd. It is subject to return on demand.</p>	<p>Owner :</p> <p>RHB TRUSTEES BERHAD (AS TRUSTEE FOR AXIS REIT) LEVEL 11, TOWER ONE, RHB CENTRE, JALAN TUN RAZAK 50400 KUALA LUMPUR</p>	<p>Architects:</p> <p>KOOI KEAT ARCHITECT no.19, taman bukit dumar, 11600 pangang, malaysia. tel: 03-661 0917 email: kooi@kooiarchitect.com.my</p>	<p>M&E Consulting Engineers :</p> <p>HAN YANG CONSULTANCY SDN BHD MECHANICAL & ELECTRICAL CONSULTING ENGINEERS 12-0, Jalan Angkasa 2, 11000 Bandar Baru Ayer Itam, Pulau Pinang Tel: 04-6254488 Fax: 04-6252280 E-mail: hanyang@hyc.com</p>	<p>Main Contractor :</p> <p>AME — CONS. KUCIOTR — AME CONSTRUCTION SDN BHD NO. 16, JALAN ANDRASA MAS 6 KAWASAN PERINDUSTRIAN TERBUKA 2 81100 JOHOR BAHRU, JOHOR TEL: 07-3555 111 FAX: 07-3541 843 EMAIL: amec@ameconstruction.com.my WEBSITE: www.ameconstruction.com.my</p>	<p>Air-Conditioning Contractor :</p> <p>RYAB engineering services sdn. bhd. No.11 & 12, Jalan Sepadu 1/55/A, Taman Perindustrian Aca, Seksyen 20, 40400 Shah Alam, Selangor Tel :- 03-51048518 Email: ryab@ryabengineering.com kwo1279@gmail.com</p>	<p>Project Name :</p> <p>CADANGAN PEMBANGUNAN MEMBINA GUDANG MERANGKUMI +</p> <p>1. FASA 1 - GUDANG 1 TINGKAT (120m x 320m) DENGAN PEJABAT / BLOK SOBAL 2. TINGKAT SERBA SEBEDI PENCAWANG 3. UNIT PERKHIDMATAN 4. UNIT TEMPA / PEMBANGUNAN SAMPAH 5. UNIT WASTE TREATMENT TANK, 1 UNIT RUMAH PAM.</p> <p>DIAATAS LOT 7316 (P.T. 3609) JALAN KLANG - BAHING, ALURM TELUK PANCIJANA GARING, DAERAH KUALA LANGAT, SELANGOR DARUL EHSAN.</p> <p>UNTUK TELUAN : RHB TRUSTEES BERHAD, (AS TRUSTEE FOR AXIS REAL ESTATE INVESTMENT TRUST)</p>	<p>Subject :</p> <p>COOLING TOWER</p>
	<p>Checked By : Charlie</p>						
	<p>Designed By : Charlie</p>						
	<p>Drawn By : Siti</p>						
	<p>Date : 10/01/18 Job Ref : 004-2018-NDC</p>						
	<p>Scale : N.T.S (AS)</p>						
<p>Drawing No : HRB/AXIS/NDC/004/00/18-CY.1(AMB)</p>							