


WALL MOUNTED PANEL (5NOS)

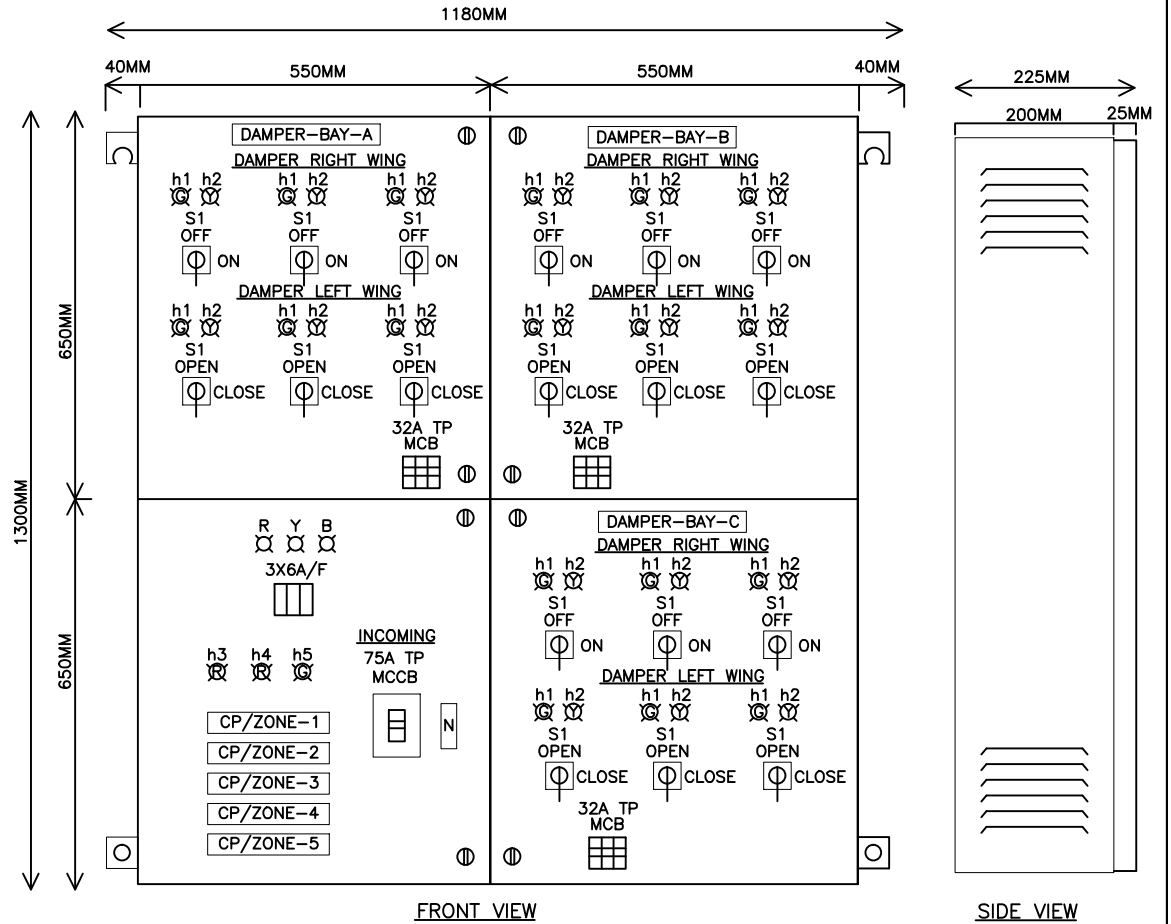

LEGEND			ORIGINAL COUNTRY
SYMBOL	DESCRIPTION	BRAND	
S/B/M/T	SWITCH BOARD METAL THICKNESS (1.5MM)	WALL MOUNTED	MALAYSIA
P/C	POWER COATING	OXYPLAST	MALAYSIA
COLOUR	FF-160/858/CW25 (LIGHT GREY)	OXYPLAST	MALAYSIA
MCCB	MOULDED CASE CIRCUIT BREAKER	TERASAKI	JAPAN
MCB	MINIATURE CIRCUIT BREAKER	SCHNEIDER	FRANCE
D/C	DAMPER MAGNETIC CONTACTOR	SCHNEIDER	FRANCE
FR/CR	FIRE & CONTROL RELAY	SCHNEIDER	FRANCE

- h1--DAMPER OPEN LIGHT
- h2--DAMPER CLOSE LIGHT
- h3--FIRE SIGNAL-1 ON LIGHT
- h4--FIRE SIGNAL-2 ON LIGHT
- h5--0-30MIN TIME ON BYPASS DAMPER OPEN LIGHT
- S1--SELETOR ON DAMPER CLOSE SWITCH

AS-BUILT DRAWING

<p>NOTICE</p> <p>This drawing and all information thereon is the property of BVAR engineering services sdn. bhd. No.5A & 5B, Jalan Sepuluh 425/A, Taman Perindustrian Axis, Seksyen 35, 40400 Shah Alam, Selangor Darul Ehsan. Tel : +603-41219340 Fax : +603-41219310/20</p> <p>This drawing and all information thereon is confidential and must not be made public, copied or used to disadvantage BVAR engineering services sdn. bhd. It is subject to return on demand.</p>	<p>Owner :</p> <p>RHB TRUSTEES BERHAD (AS TRUSTEE FOR AXIS REIT) LEVEL 11, TOWER ONE, RHB CENTRE, JALAN TUN RAZAK 50400 KUALA LUMPUR</p>	<p>Architect:</p> <p>KOOI KEAT ARCHITECT No.19, Jalan Daki Dumar, 11600 Penang, Malaysia. Tel: 04-659 9987 Fax: 04-656 9478 e-mail: kooikeat@kooikeatarchitect.com.my</p>	<p>M&E Consulting Engineers :</p> <p>FIG FIB Consultants Sdn Bhd No. 12-A, 4th Floor, Jalan 5/114, Section 5, Petaling Jaya, Selangor Darul Ehsan, Malaysia. Tel: 03-7606210 / 03-7606218 Fax: 03-7606218</p>	<p>Main Contractor :</p> <p>AME CONSTRUCTION SDN BHD NO. 18, JALAN ANKASA MAS 8, KAWASAN PERINDUSTRIAN TERBAJU 2, 81100 JOHOR BAHRU, JOHOR TEL: 07-3550 111 FAX: 07-3541 048 EMAIL: info@ameconstruction.com.my WEBSITE: www.ameconstruction.com.my</p>	<p>Air-Conditioning Contractor :</p> <p>BVAR engineering services sdn. bhd. No.5A & 5B, Jalan Sepuluh 425/A, Taman Perindustrian Axis, Seksyen 35, 40400 Shah Alam, Selangor. Tel : +603-41219340 Fax : +603-41219310/20 Email: bvarengineering@yahoo.com bvar1879@gmail.com</p>	<p>Project Name :</p> <p>CADANGAN PEMBANGUNAN MEMBINA GUDANG MERANGKUMI-> 1. FASA 1 - GUDANG 1 TINGKAT (120m X 360m) DENGAN PEABAT / BLOK SOSIAL 2. TINGKAT SEPA SEBUAH PENGAWANG ELEKTRIK 3 UNIT PONDOK PENGAWAL 1 UNIT ISAPAI PUSYANGKIAN SAMPAH 1 UNIT WASTE TREATMENT TANK, 1 UNIT RUMAH PAM. DIATAS LOT 7316 (P.T. 3409) JALAN KLANG - BANTING, MUKIM TELUK PANGLIMA GAMPANG, DAERAH KUALA LANGAT, SELANGOR DARUL EHSAN. UNTUK TITILAH : RHB TRUSTEES BERHAD. (AS TRUSTEE FOR AXIS REAL ESTATE INVESTMENT TRUST)</p>	<p>Subject :</p> <p>CONTROL PANEL LAYOUT PLAN @ WAREHOUSE (WAREHOUSE - ZONES 1 TO 5)</p> <p>Checked By : Charlie Designed By : Charlie Drawn By : SH/Pjja Date : 18/01/18 Job Ref : 040-2017-AMS Scale : N.T.S. (A3) Drawing No : RES/AMS/MR/040/05/17-01/MR0.1(A3B)</p>
---	---	--	--	--	---	---	--