


CHWP-1/2/3/4

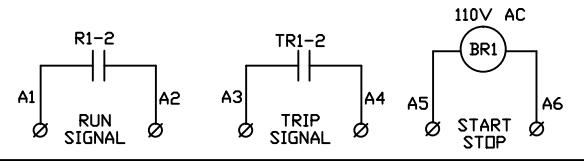

AS-BUILT DRAWING

<p>NOTICE</p> <p>This drawing and all information thereon is the property of HVAR engineering services sdn. bhd. No.5A & 5B, Jalan Sepadu A50/A, Taman Perindustrian Axis, Seksyen 05, 40400 Shah Alam, Selangor Darul Ehsan. Tel :- 03-51948210 Fax :- 03-51948119/20</p> <p>This drawing and all information thereon is confidential and must not be made public, copied or used to disadvantage HVAR engineering services sdn. bhd. It is subject to return on demand.</p>	<p>Owner :</p> <p>RHB TRUSTEES BERHAD (AS TRUSTEE FOR AXIS REIT) LEVEL 11, TOWER ONE, RHB CENTRE, JALAN TUN RAZAK 50400 KUALA LUMPUR</p>	<p>Architect:</p> <p>KOOI KEAT ARCHITECT No.19, Jalan Sultan Abdul Samad, 11600 Seri Kembangan, Malaysia. Tel: 04-659 9987 fax: 04-656 8478 e-mail: kooikeat@kooikeatarchitect.com.my</p>	<p>M&E Consulting Engineers :</p> <p>HAN YANG CONSULTANCY SDN BHD MECHANICAL & ELECTRICAL CONSULTING ENGINEERS 12-11, Medan Regency 2, 11500 Bandar Baru Ayer Itam, Pulau Pinang. Tel: 04-2294488 Fax: 04-2222288 E-mail: hanyang@hycb.com</p>	<p>Main Contractor :</p> <p>AME CONSTRUCTION — CONSTRUCTION — AME CONSTRUCTION SDN BHD NO. 18, JALAN ANGKASA MAS 6, KAWASAN PERINDUSTRIAN TEBERAU 2 81100 JOHORE BARU, JOHORE. TEL: 07-3550111 FAX: 07-3541648 EMAIL: info@ameconstruction.com.my WEBSITE: www.ameconstruction.com.my</p>	<p>Air-Conditioning Contractor :</p> <p>HVAR engineering services sdn. bhd. No.5A & 5B, Jalan Sepadu A50/A, Taman Perindustrian Axis, Seksyen 05, 40400 Shah Alam, Selangor. Tel :- 03-51948210 Fax :- 03-51948119/20 Email: hvar@hvarengineering.com hvar1779@gmail.com</p>	<p>Project Name :</p> <p>CADANGAN PEMBANGUNAN MEMBINA GUDANG MERANGKUM :- 1. FASA 1 - GUDANG 1 TINGKAT (120m X 360m) DENGAN PEJABAT / BLOK SOSIAL 2. TINGKAT SERTA SEBUAH PENCAWANG ELEKTRIK, 3 UNIT PONDOK PENGAWAL, 1 UNIT TEMPAT PEMBUANGAN SAMPAH, 1 UNIT WASTE TREATMENT TANK, 1 UNIT RUMAH PAK. DIATAS L07 7316 (P.I. 3609) JALAN KLANG - BANTING, MUKOM TELUK PANGUKA GARANG, DAERAH KUALA LANGAT, SELANGOR DARUL EHSAN. UNTUK TETAPAN : RHB TRUSTEES BERHAD, (AS TRUSTEE FOR AXIS REAL ESTATE INVESTMENT TRUST)</p>	<p>Subject :</p> <p>CONTROL CIRCUIT</p> <p>Checked By : Charlie</p> <p>Designed By : Charlie</p> <p>Drawn By : SHI</p> <p>Date : 18/01/18 Job Ref : 094-2016-NDC</p> <p>Scale : N.T.S.</p> <p>Drawing No : HBS/AXIS/NDC/094/09/16-CF.4(ABD)</p>
--	--	---	--	--	--	---	---