


MCCB---TERASAKI
MCB/ELCB---SCHNEIDER
CONTACTOR---SCHNEIDER
CONTROL RELAY---SCHNEIDER
24H T/S---HAGER

- h1---B/FAN RUN LED LIGHT
- h2---COMP RUN LED LIGHT
- h3---COMP TRIP LED LIGHT
- h4---COMP CCH LED LIGHT
- b1---MANUAL STOP PUSH BUTTON
- b2---MANUAL START PUSH BUTTON

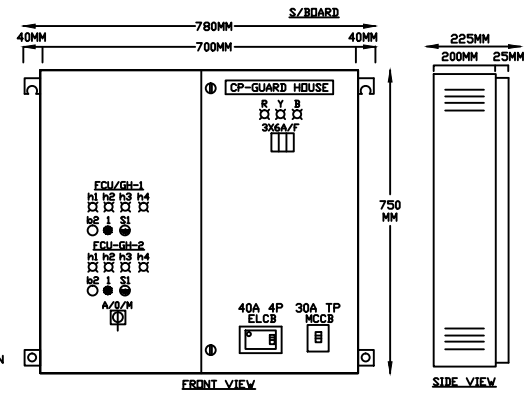

AS-BUILT DRAWING

NOTICE
This drawing and all information thereon is the property of RHB engineering services sdn. bhd. No.14 & 15, Jalan Sepadu A50/A, Taman Perindustrian Axis, Seksyen 05, 40400 Shah Alam, Selangor Darul Ehsan. Tel :- 03-51548213 Fax :- 03-51548219/20
This drawing and all information thereon is confidential and must not be made public, copied or used to disadvantage RHB engineering services sdn. bhd. It is subject to return on demand.

Owner :
RHB TRUSTEES BERHAD
(AS TRUSTEE FOR AXIS REIT)
LEVEL 11, TOWER ONE,
RHB CENTRE, JALAN TUN RAZAK
50400 KUALA LUMPUR

Architect:
KOOI KEAT ARCHITECT
No.19, Laman 3, Jalan Sultan Abdul Halim, 11600 Cyberjaya, Malaysia.
Tel: 04-659 9987 Fax: 04-656 8478 E-mail: kooikeat@kooikeatarchitect.com.my

M&E Consulting Engineers :
HAN YANG CONSULTANCY SDN BHD
MECHANICAL & ELECTRICAL CONSULTING ENGINEERS
12-4, Medan Regency 2,
11500 Bandar Baru Ayer Itam,
Pulau Pinang.
Tel: 04-4294488 Fax: 04-4222289
E-mail: hanyang@hanyangsdn.com

Main Contractor :
AME CONSTRUCTION
AME CONSTRUCTION SDN BHD
NO. 18, JALAN LANGKASA MAS 6,
KAWASAN PERINDUSTRIAN TERBUKA 2
81100 JOHOR BARU, JOHOR.
TEL: 07-8550111 FAX: 07-3541648
EMAIL: info@ameconstruction.com.my
WEBSITE: www.ameconstruction.com.my

Air-Conditioning Contractor :
RHB engineering services sdn. bhd.
No.14 & 15, Jalan Sepadu A50/A,
Taman Perindustrian Axis, Seksyen
05, 40400 Shah Alam, Selangor.
Tel :- 03-51548213
Fax :- 03-51548219/20
Email: rhbengineering@rhb.com
hrv1779@gmail.com

Project Name :
CADANGAN PEMBANGUNAN MEMBINA GUDANG MERANGKUM :-
1. FASA 1 - GUDANG 1 (120m X 360m) DENGAN PEJABAT / BLOK SOSAL
2. INKAT SERTA SEBUAH PENCAWANG ELEKTRIK, 3 UNIT PONDOK PENGAWAL,
1 UNIT TEMPAT PEMBIANGAN SAMPAH,
1 UNIT WASTE TREATMENT TANK, 1 UNIT BUKAH PAK.
DIATAS L07 7316 (P.T. 3679)
JALAN KLANG - BANTING, MUKIM TELUK PANGKAMA GARANG, DAERAH KUALA LANGAT, SELANGOR DARUL EHSAN.
UNTUK TETAPAN : RHB TRUSTEES BERHAD, (AS TRUSTEE FOR AXIS REAL ESTATE INVESTMENT TRUST)

Subject :
POWER CIRCUIT & SWITCHBOARD FOR GUARD HOUSE

Checked By : Charlie
Designed By : Sidi
Date : 18/01/18 **Job Ref :** 094-2016-NDC
Scale : N.T.S.
Drawing No : HRS/AXIS/NDC/094/09/16-CF.GH(AB)