
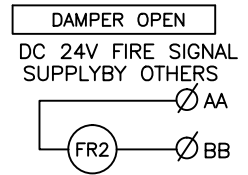


CONTROL DAMPER
NORMAL=OPEN
FIRE SIGNAL=1 CLOSE
FIRE SIGNAL=2 OPEN
1XO-30MIN TIME RELAY
BYPASS DAMPER OPEN
FOR SIGNAL=2 FAULT USE
FIRE CONTROL ROOM
OPEN/NORMAL/CLOSE
SELETOR SWITCH

TESTING & EMERGENCY FOR USE

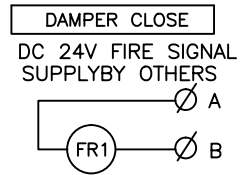

AS-BUILT DRAWING

NOTICE
This drawing and all information thereon is the property of BVAR engineering services sdn. bhd. No.5A & 5B, Jalan Sepuluh A25/A, Taman Perindustrian Axis, Seksyen 35, 40400 Shah Alam, Selangor Darul Ehsan. Tel : +603-41218248 Fax : +603-41218210-20
This drawing and all information thereon is confidential and must not be made public, copied or used to disadvantage BVAR engineering services sdn. bhd. It is subject to return on demand.

Owner :
RHB TRUSTEES BERHAD
(AS TRUSTEE FOR AXIS REIT)
LEVEL 11, TOWER ONE,
RHB CENTRE, JALAN TUN RAZAK
50400 KUALA LUMPUR

Architect:

KOOI KEAT ARCHITECT
No.19, Jalan D'Almeida, 11600 Penang, Malaysia.
Tel: 04-659 9987 Fax: 04-656 8478 e-mail: kooikeat@kooikeatarchitect.com.my

M&E Consulting Engineers :

FIS FIS Consultancy Sdn Bhd
No.12-4, 4th Floor, Jalan 3/114,
KUALA BENDU CONDO,
OFF JALAN BESSEH LAMA,
SEKSYEN 13, 40100 Shah Alam, Selangor.
TEL: 65-7948220 / 65-7948218
FAX: 65-7948216

Main Contractor :

AME CONSTRUCTION SDN BHD
NO. 18, JALAN ANKASAMA MAS 8
KAWASAN PERINDUSTRIAN TERBAJU 2
81100 JOHOR BAHRU, JOHOR
TEL: 07-3550 111 FAX: 07-3541 648
EMAIL: info@ameconstruction.com.my
WEBSITE: www.ameconstruction.com.my

Air-Conditioning Contractor :

BVAR engineering services sdn. bhd.
No.5A & 5B, Jalan Sepuluh A25/A,
Taman Perindustrian Axis, Seksyen
35, 40400 Shah Alam, Selangor.
Tel : +603-41218248
Fax : +603-41218210-20
Email: bvarengineering@yahoo.com
bvar1879@gmail.com

Project Name :
CADANGAN PEMBANGUNAN MEMBINA GUDANG
MERANGKUMI->
1. FASA 1 - GUDANG 1 TINGKAT (120m X 360m)
DENGAN PEJABAT / BLOK SOSIAL
2. TINGKAT SERTA SEBUAH PENGAWANG
ELECTRIC 3. UNIT PONDOK PENGAWAL
1. UNIT BAKPAI PEMBERSIHAN SAMPAH
1. UNIT WASTE TREATMENT TANK, 1. UNIT
RUMAH PAM.
DIATAS LOT 7316 (P.T. 3409)
JALAN KLANG - BANTING, MUKIM TELUK PANGLIMA,
GAWANG, DAERAH KUALA LANGAT,
SELANGOR DARUL EHSAN.
UNTUK TELAHAN : RHB TRUSTEES BERHAD,
(AS TRUSTEE FOR AXIS REAL ESTATE INVESTMENT TRUST)

Subject :
CONTROL CIRCUIT LAYOUT PLAN
(GARIBD 1101-SE)
Checked By : Charlie
Designed By : Charlie
Drawn By : SH/Phj
Date : 14/01/18 Job Ref : 040-2017-AMS
Scale : N.T.S. (A3)
Drawing No : BES/AMS/SDC/010/05/15-CP/MFD.6(ABD)