


Side View

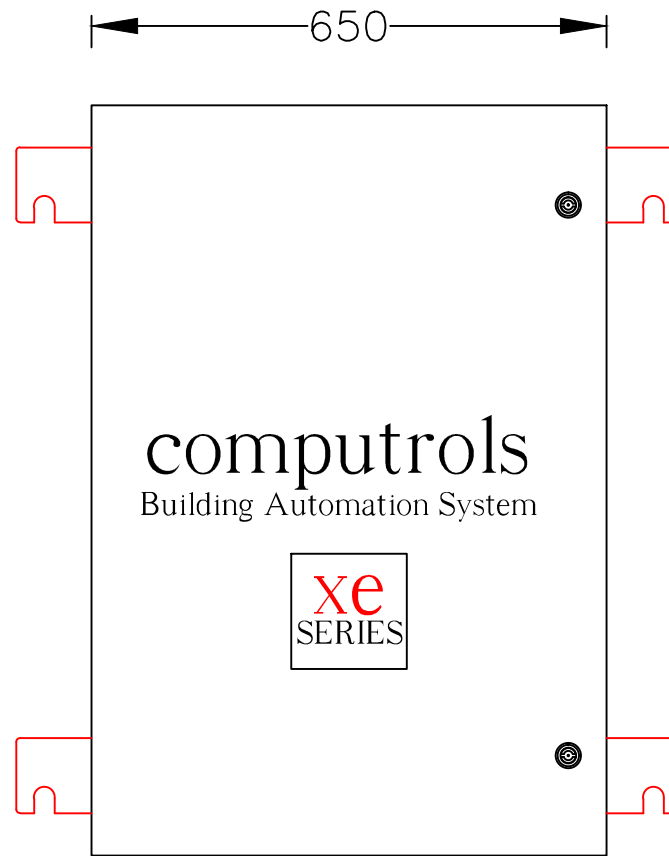

Front View

AS-BUILT DRAWING

<p>NOTICE This drawing and all information thereon is the property of RYAB engineering services sdn. bhd. No.11 & 12, Jalan Sepadu 1/15/A, Taman Perindustrian Aca, Seksyen 20, 40400 Shah Alam, Selangor Darul Ehsan. Tel :- 03-51048518 Fax :- 03-51048519/20</p> <p>This drawing and all information thereon is confidential and must not be made public, copied or used to disadvantage RYAB engineering services sdn. bhd. It is subject to return on demand.</p>	<p>Owner : RHB TRUSTEES BERHAD (AS TRUSTEE FOR AXIS REIT) LEVEL 11, TOWER ONE, RHB CENTRE, JALAN TUN RAZAK 50400 KUALA LUMPUR</p>	<p>Architects : KOOI KEAT ARCHITECT no.19, taman Bukit Jambul, 11600 Banting, Malaysia. tel: 06-656 8878 email: kooi@kooiarchitect.com.my</p>	<p>M&E Consulting Engineers : HAN YANG CONSULTANCY SDN BHD MECHANICAL & ELECTRICAL CONSULTING ENGINEERS 12-0, Jalan Angkasa 2, 10200 Bandar Baru Ayer Itam, Pulau Pinang Tel: 04-2254488 Fax: 04-2252280 E-mail: hanyang@hycs.com</p>	<p>Main Contractor : AME — CONS. KUCIOTR — AME CONSTRUCTION SDN BHD NO. 16, JALAN ANGKASAMAS 6 KAWASAN PERINDUSTRIAN TERBRAU 2 81100 JOHOR BARU, JOHORE TEL: 07-3555 111 FAX: 07-3541 843 EMAIL: — info@ameconstruction.com.my WEBSITE: www.ameconstruction.com.my</p>	<p>Air-Conditioning Contractor : RYAB engineering services sdn. bhd. No.11 & 12, Jalan Sepadu 1/15/A, Taman Perindustrian Aca, Seksyen 20, 40400 Shah Alam, Selangor Tel :- 03-51048518 Fax :- 03-51048519/20 Email: ryab@engineeringryab.com kwe1879@gmail.com</p>	<p>Project Name : CADANGAN PEMBANGUNAN MEMBINA GUDANG MERANGKUM + 1. FASA 1 - GUDANG 1 TINGKAT (120m x 360m) DENGAN PEJABAT / BLOK SOBAL 2. TINGKAT SERA SEBDAH PENCAWANG REKREASI, 3. LINE PONDOK PENGAWAL, 1. UNIT TEMPA/ PEMBANGUNAN SAMPAH, 1. UNIT WASTE TREATMENT TANK, 1. UNIT RUMAH PAM. DIATAS LOT 7316 (P.T. 3609) JALAN KLANG - BANTING, MUKIM TELUK PANCIJANA GARING, DAERAH KUALA LANGAT, SELANGOR DARUL EHSAN. UNTUK TELUAN : RHB TRUSTEES BERHAD, (AS TRUSTEE FOR AXIS REAL ESTATE INVESTMENT TRUST)</p>	<p>Subject : CUBICLE LAYOUT FOR BAS BOARD</p> <p>Checked By : Charlie Designed By : Charlie Drawn By : Siti Date : 18/01/18 Job Ref : 004-2018-NDC Scale : N.T.S (A3) Drawing No : RHB/AXIS/NDC/004/09/18-BAS.1(ASB)</p>
---	---	---	---	---	---	--	--