

AS-BUILT DRAWING

TAJUK PROJEK
 KERLULUSAN PELAN BANGUNAN BAGI :
 CADANGAN PEMBANGUNAN MEMBINA GUDANG
 MERANGKUMI :
 1. FASA 1 - GUDANG 1 TINGKAT (120m X 360m)
 DENGAN PEJABAT / BLOK SOSIAL
 2. TINGKAT SERTA SEBUAH PENCAWANG
 ELEKTRIK DAN SERAHS SEBAHAGIAN
 TANAH DIBAWAH SEKSYEN 200 KTN
 UNTUK KOLAM TAKUNGAN (2.414 ekor)
 DIATAS LOT 7316 (P.T. 3609)
 JALAN KLANG - BANTING, MUKIM TELUK PANGLIMA
 GARANG, DAERAH KUALA LANGAT,
 SELANGOR DARUL EHSAN.
 UNTUK TETUAN : RHB TRUSTEES BERHAD.
 (AS TRUSTEE FOR AXIS REAL ESTATE INVESTMENT TRUST)

TANDATANGAN PEMAJU
 MR. TONY CHIENG SIONG LING NO.K.P. : 730508-13-5227
 (JAWATAN : PENGARAH URUSAN)
RHB TRUSTEES BERHAD (673019-U)
 (Sy. Terdaftar di SINGAPORE)
 RHB CENTRE, JALAN TUN RAZAK,
 50000 KUALA LUMPUR, MALAYSIA.
 TEL: +603-9280 8799 FAX: +603-9280 8796
 MAKLUMAT ARKITEK

TANDATANGAN ARKITEK

OOI KOOI KEAT K/P: 720817-07-5361
 ARKITEK PROFESIONAL
 No. Pendaftaran: OAM 14281
KOOI KEAT ARCHITECT
 NO. 19, TAMAN BUKIT DUMBAR, 11600 PENANG, MALAYSIA.
 W: 04-659 9987 S: 04-659 9478 E-MAIL: kkoos@cc.com.my
 "SAYA MEMPERAKUI BAHAWA BUTIRAN-BUTIRAN DALAM PELAN PELAN ADALAH
 MENURUT KEHENDAK-KEHENDAK UNDANG-UNDANG KECEK, BANGUNAN BERKUALITI
 SELANGOR 1995 DAN SAYA SETUJU TERIMA TANGGUNG JAWAB PERUBIHAN
 SEWAKWARNYA."

HAN YANG CONSULTANCY SDN BHD
 MECHANICAL & ELECTRICAL CONSULTING ENGINEERS
 12-B, Medan Angsana 2,
 11500 Bandar Baru Ayer Ram,
 Pulau Pinang.
 Tel: 04-8294489 Fax: 04-8292289
 E-mail: hanyang.sdn.bhd@gmail.com

MAIN CONTRACTOR :
AME CONSTRUCTION SDN BHD
 NO. 18 JALAN ANOKASA MAS 6,
 KAWASAN PERINDUSTRIAN TEBRAU 2,
 81100 JOHOR BAHRU, JOHOR.
 TEL: 07-355 5111
 FAX: 07-3541648


ELECTRICAL CONTRACTOR

PUBLIC ADDRESS INSTALLATION SCHEMATIC DIAGRAM



Disemak oleh	CHAN KENG ANN		
Ditulis oleh	CHAN		
Skala			
Revisi	0		
Tglkh	DEC 2017		
NO. RUJUKAN		NO. LUK.	
KBSB/SEL-16424-PA		03	

LEGEND

SYMBOL	DESCRIPTION
	6W CEILING SPEAKER RECESS MOUNTED C/W MATCHING TRANSFORMER TAP AT 3 W
	6W BOX SPEAKER SURFACE MOUNTED C/W MATCHING TRANSFORMER TAP AT 3 W
	15W HORN SPEAKER MOUNTED AT 13m HEIGHT C/W MATCHING TRANSFORMER TAP AT 10W
	VOLUME CONTROL C/W OVERRIDING RELAY

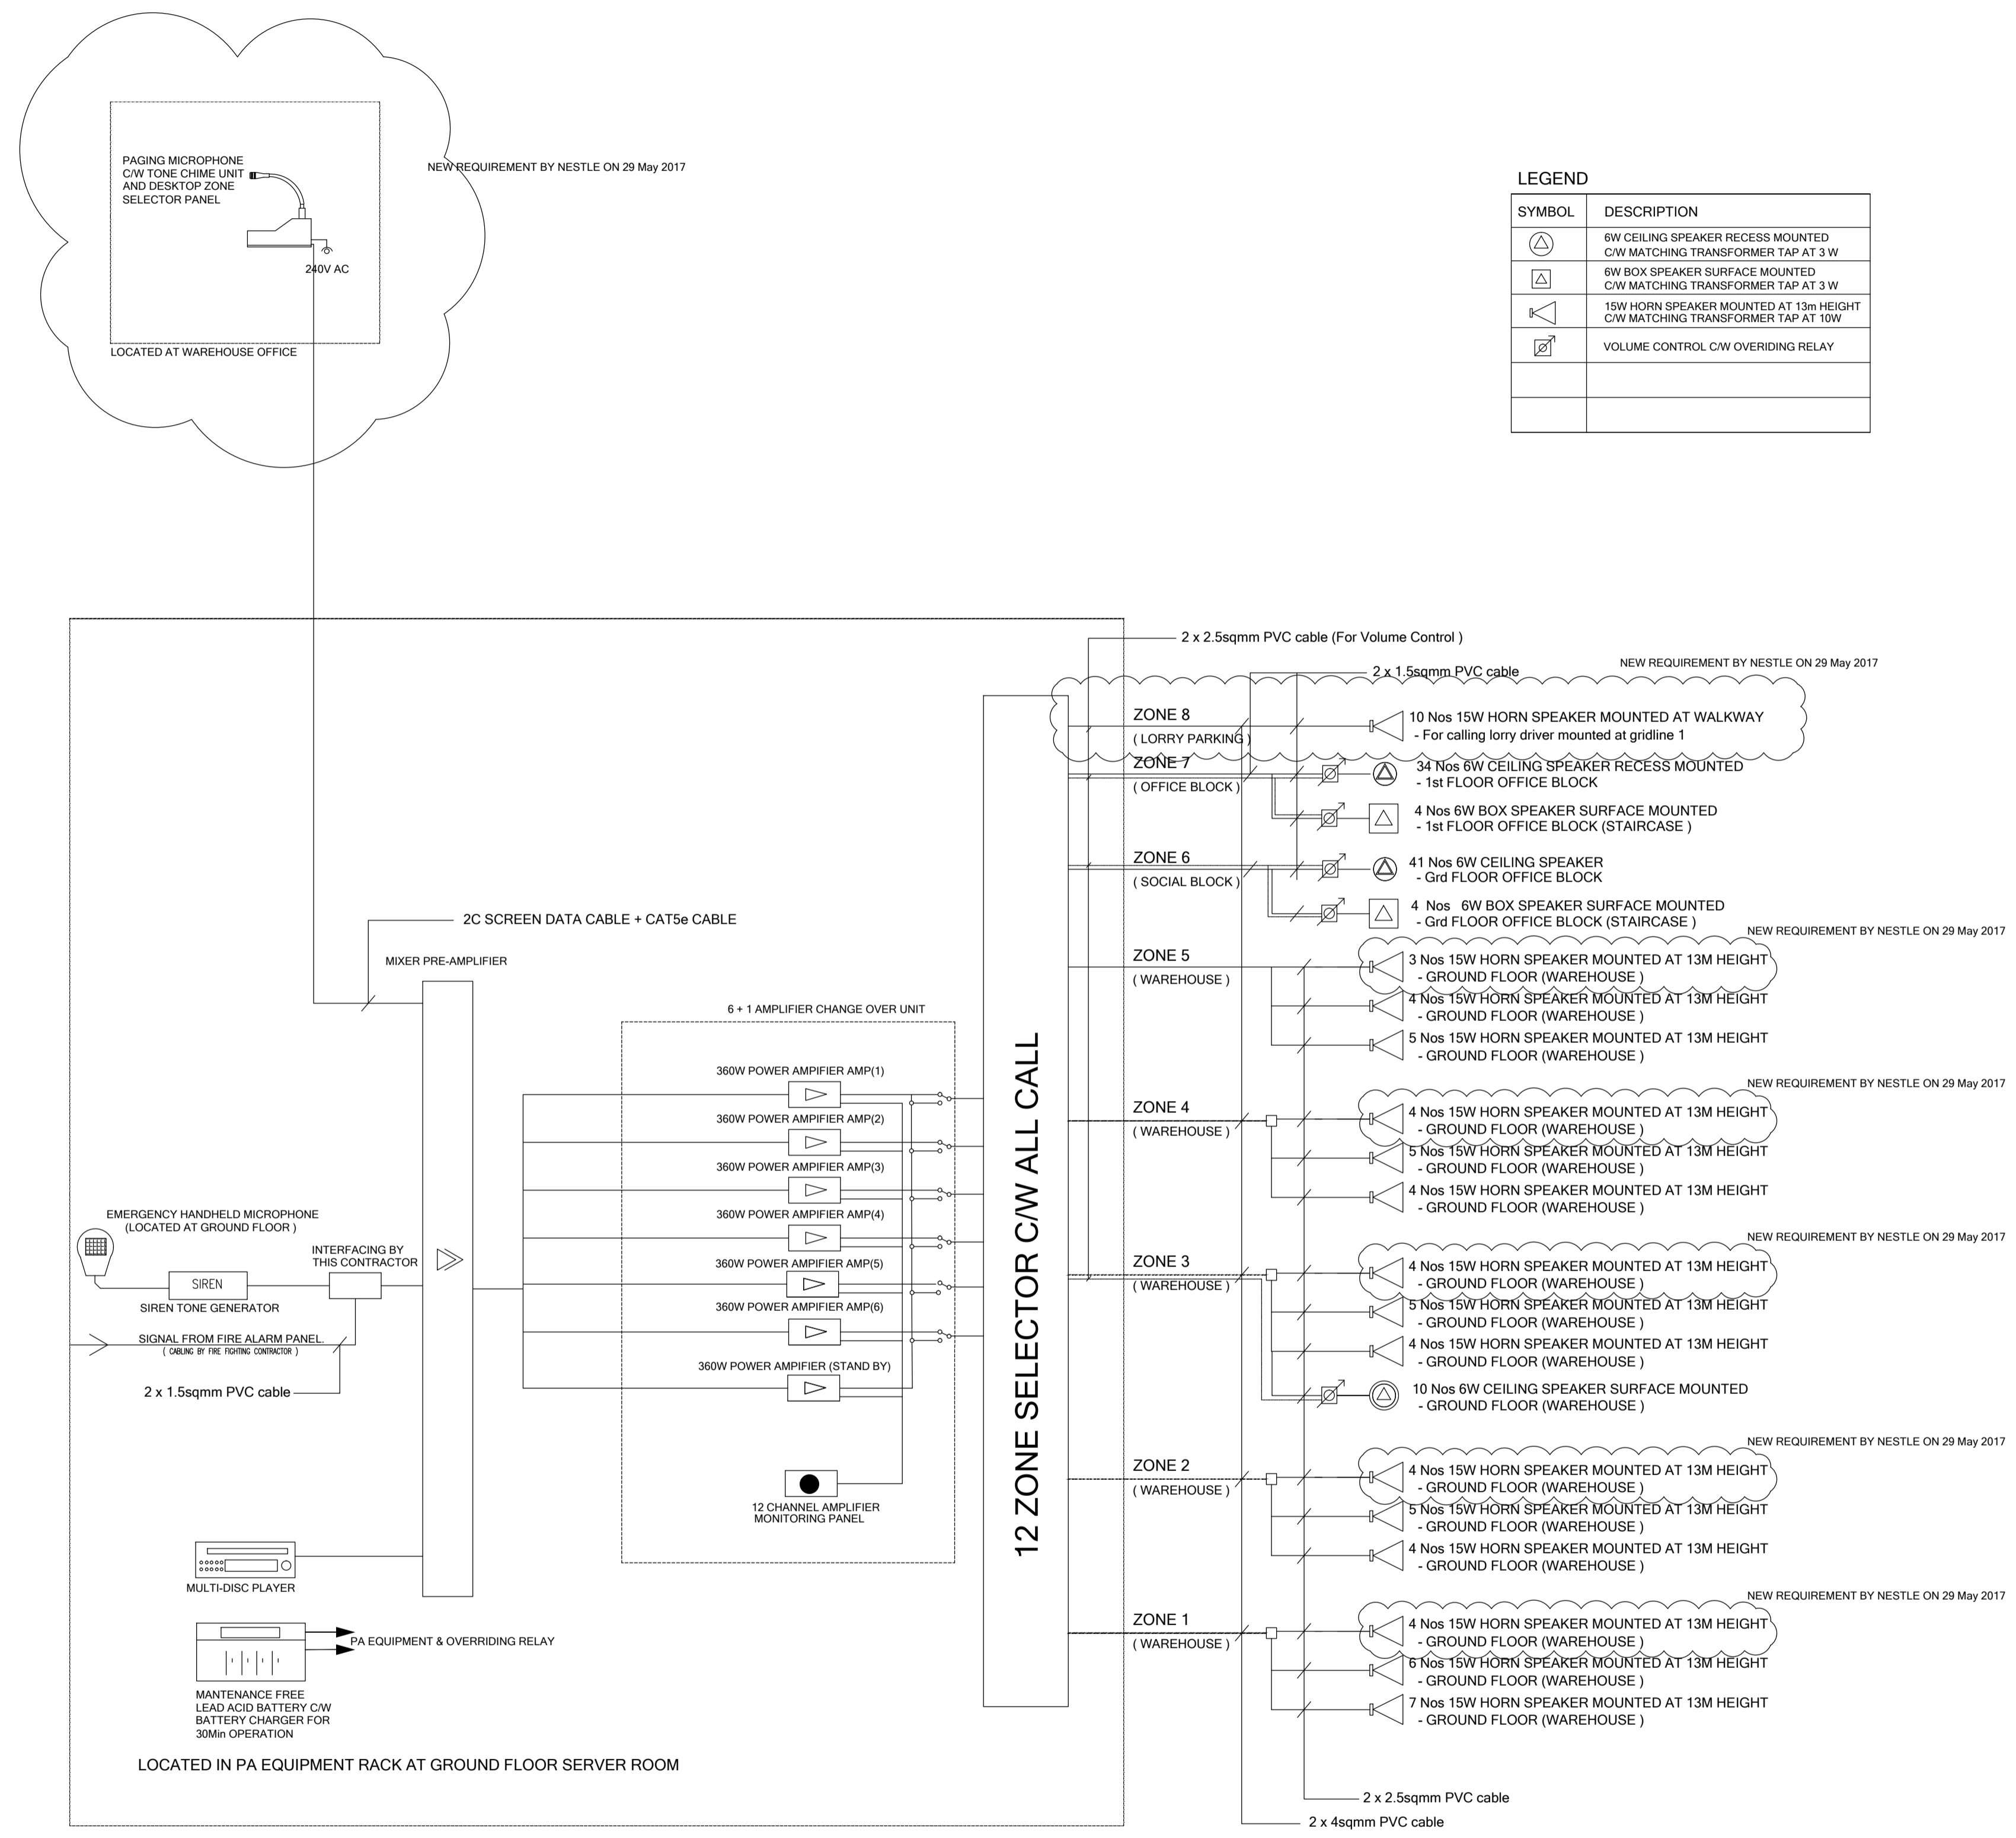

PUBLIC ADDRESS SYSTEM SCHEMATIC DIAGRAM

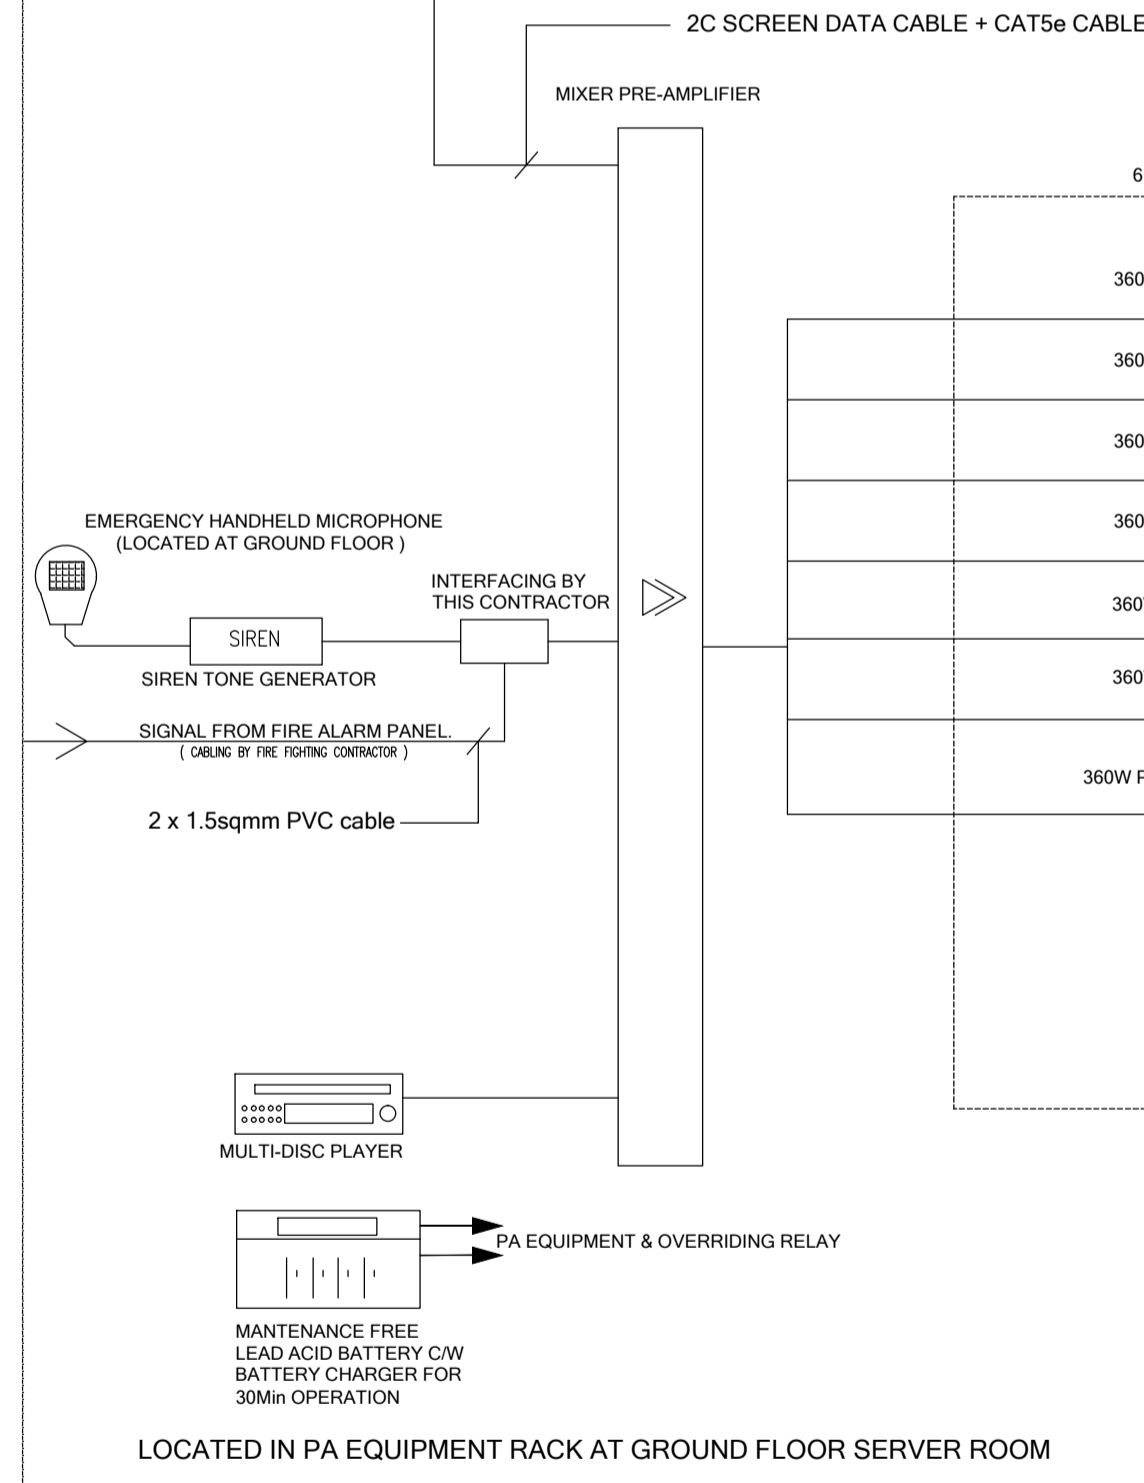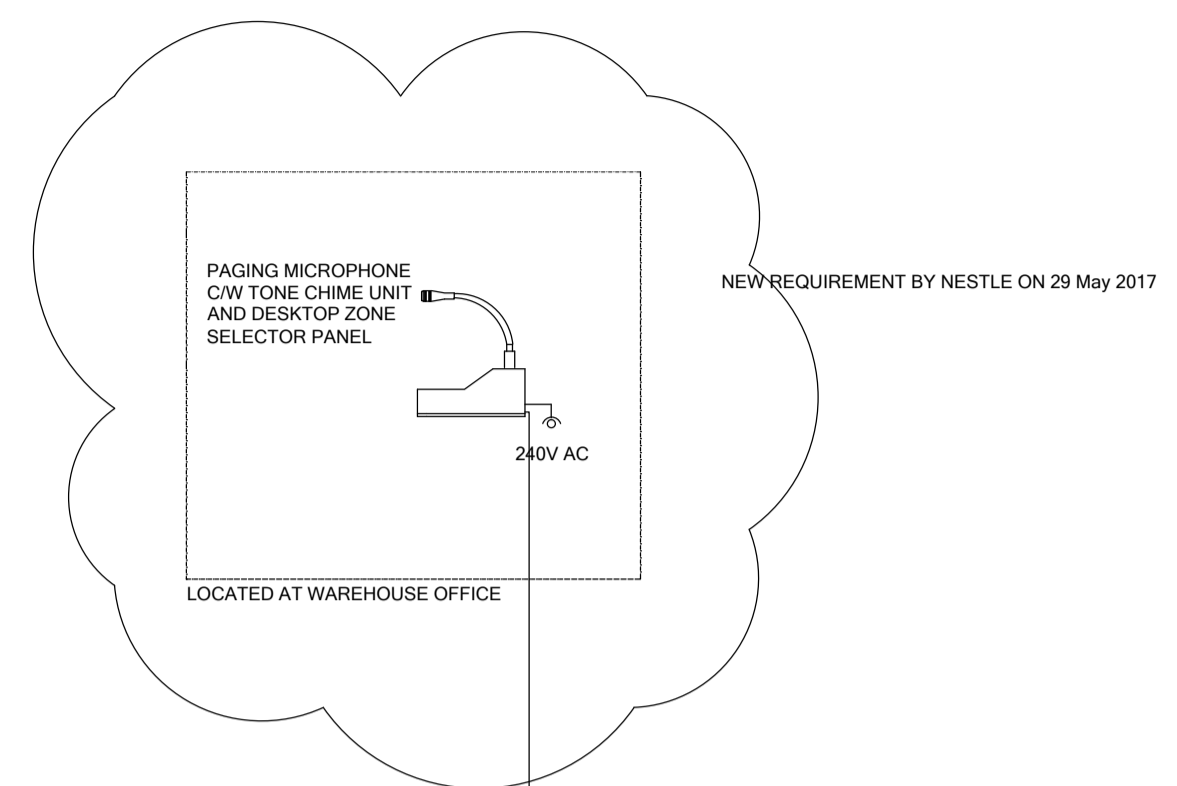

LOCATED IN PA EQUIPMENT RACK AT GROUND FLOOR SERVER ROOM