




DETAIL E.1-COORDINATION FOR SPRINKLER & AC

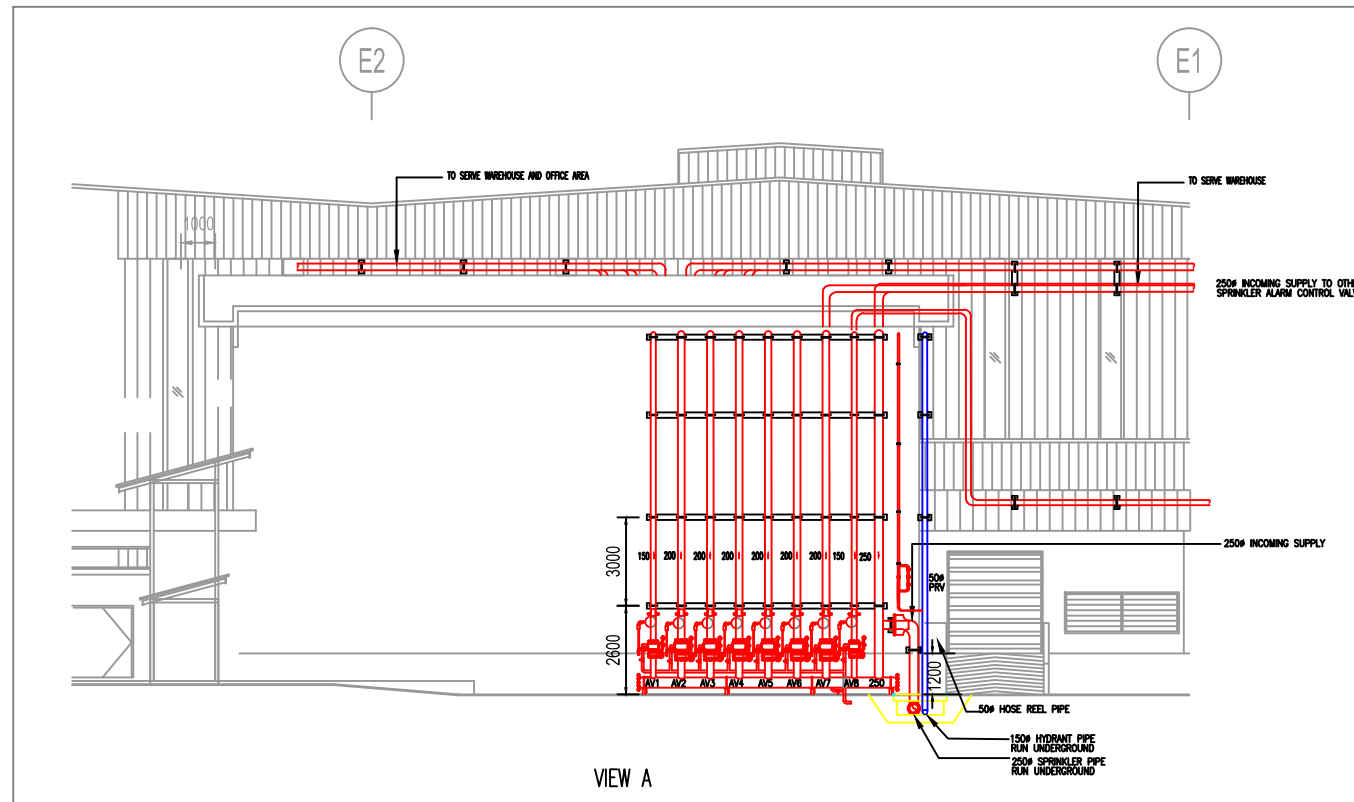

VIEW A

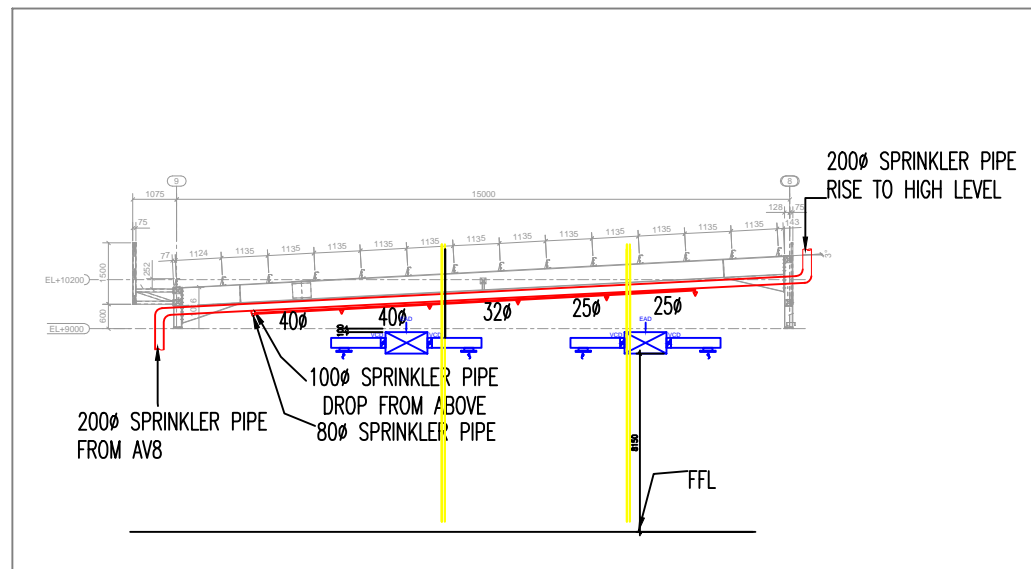

DETAIL E.2

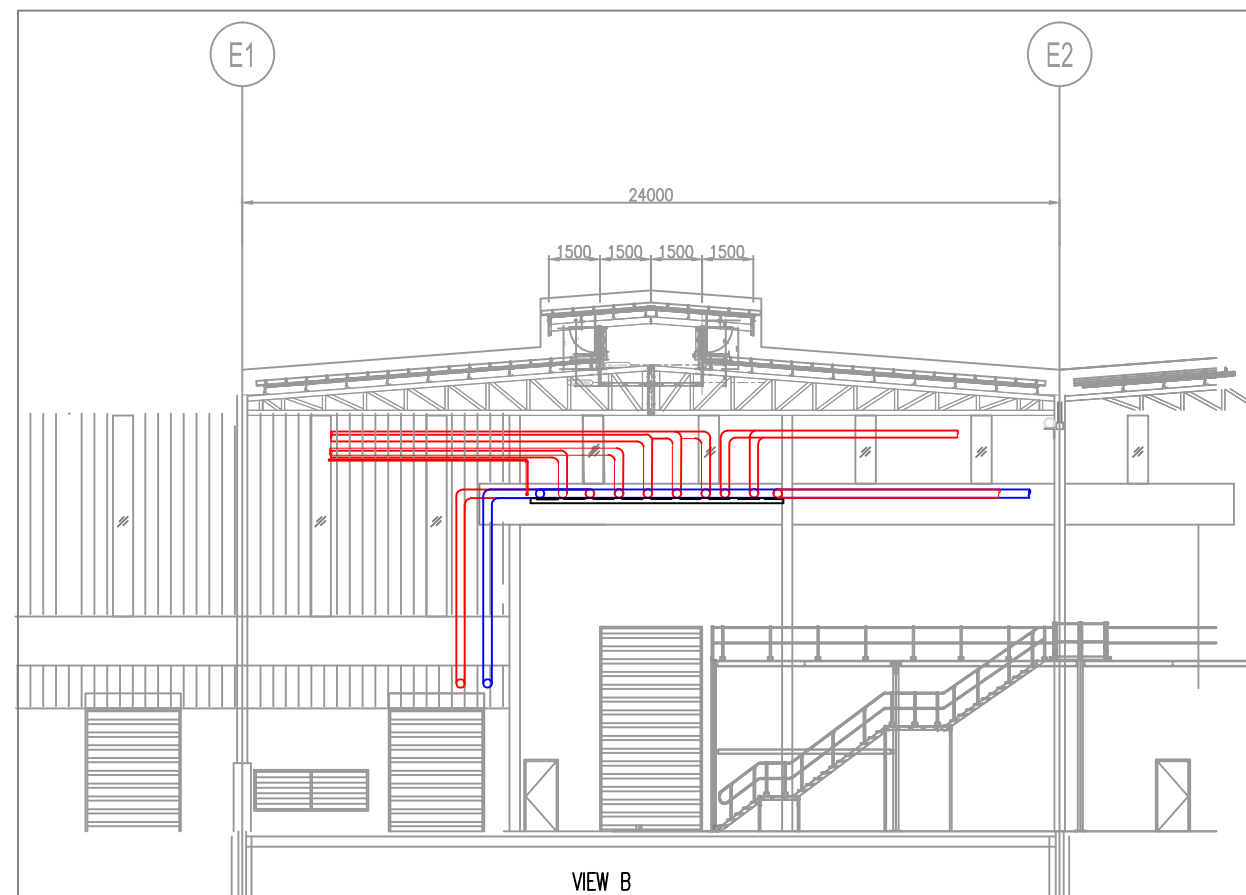

VIEW B

**PROJECT TITLE :**  
 PROPOSED CONSTRUCTION & COMPLETION OF:  
 PHASE 1 : 1-STORY WAREHOUSE (120m X 360m)  
 WITH 2-STORY OFFICE / SOCIAL BLOCK  
 INCLUDING

- a) 1 UNIT GUARD HOUSE
- b) 1 UNIT REFUSE CHAMBER
- c) 1 UNIT WASTE TREATMENT PLANT
- d) 1 UNIT PUMP HOUSE
- e) 1 UNIT TNB SUBSTATION

ON LOT 7316 (P.T. 3609),  
 JALAN KLANG - BANTING,  
 MUKIM TELUK PANGLIMA GARANG,  
 KUALA LANGAT, SELANGOR


FOR RHB TRUSTEES BERHAD  
 (AS TRUSTEE FOR AXIS REAL ESTATE INVESTMENT TRUST)

**DEVELOPER :**  
 RHB TRUSTEES BERHAD  
 (AS TRUSTEE FOR AXIS REIT)  
 LEVEL 11, TOWER ONE,  
 RHB CENTRE, JALAN TUN RAZAK,  
 50400 KUALA LUMPUR, MALAYSIA.  
 TEL: +603-9280 8799 FAX: +603-9280 8796

**ARCHITECT :**  
  
 KOOI KEAT ARCHITECT  
 No. 13, Laman Bukit Dumbur, 11000 Penang, Malaysia.  
 Tel: 04-659 9887 Fax: 04-656 8478  
 email: kooikeat@kooikeatarchitect.com.my

**M & E CONSULTANT :**  
  
 FIG Fire Consultancy Sdn Bhd  
 Fire Safety Engineering  
 UNIT 12-4, 4TH FLOOR, JALAN 3/114,  
 KUCHAI BUSINESS CENTRE,  
 OFF JALAN KUCHAI LAMA,  
 58200 KUALA LUMPUR.  
 TEL: 03-79842128 / 03-79842118  
 FAX: 03-79842158

**MAIN CONTRACTOR :**  
 AME CONSTRUCTION SDN BHD  
 NO 18 JALAN ANGKASA MAS 6,  
 KAWASAN PERINDUSTRIAN TEBRAU 2,  
 81100 JOHOR BAHRU, JOHOR.  
 TEL: 07- 355 5111  
 FAX: 07- 3541648

**FIRE FIGHTING CONTRACTOR :**  
  
 NATION FIRE ENGINEERING SDN BHD  
 (63143-D)  
 20, JALAN USJ 7/3A, UEP SUBANG JAYA,  
 47610 SUBANG JAYA, SELANGOR DARUL EHSAN.  
 TEL: 03-5621 0605/06 FAX: 03-5621 0615  
 E-MAIL: nationfire@yahoo.com

**FIRE PROTECTION SYSTEM**  
**DRAWING TITLE :**  
 DETAIL E  
 DETAIL OF MHE ROOM

**SCALE :** 1:100  
**DATE :** DECEMBER 2017  
**DRAWING BY :** FRANCIESE KANG  
**CHECK BY :** STEVEN  
**DRAWING NO :** 3428/NF/FIG/2017/FF-DTL17

**AS-BUILT DRAWING**