

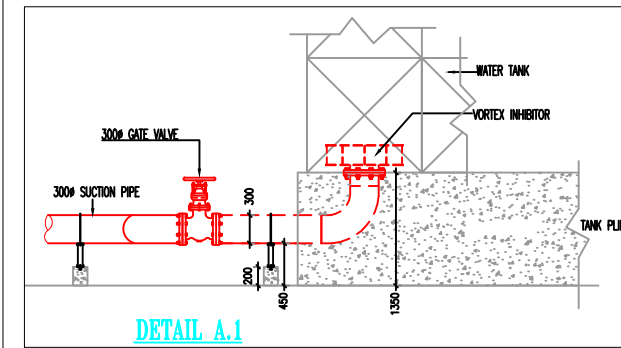


LOCATION FOR BREECHING INLET

SCALE : 1:150

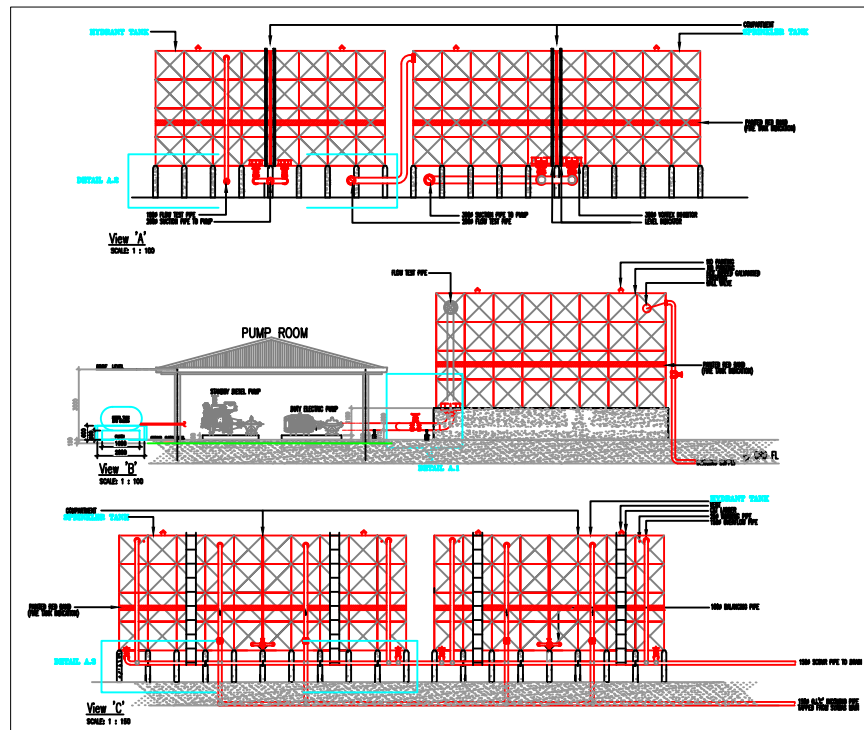


DETAIL A.1

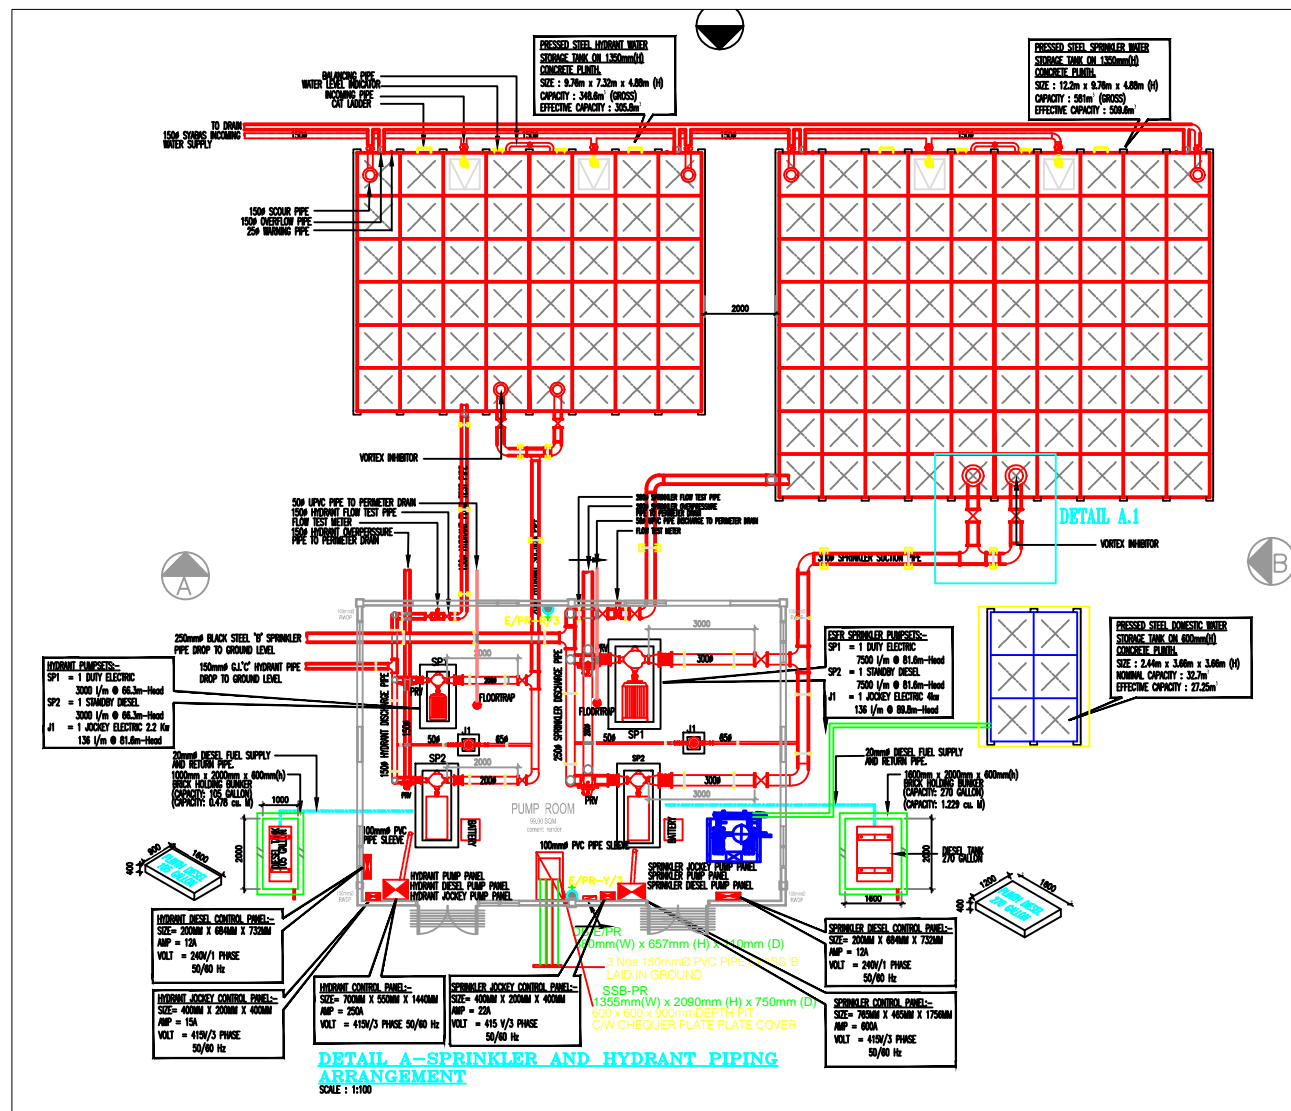


DETAIL A - SPRINKLER AND HYDRANT PIPING ARRANGEMENT

SCALE : 1:100

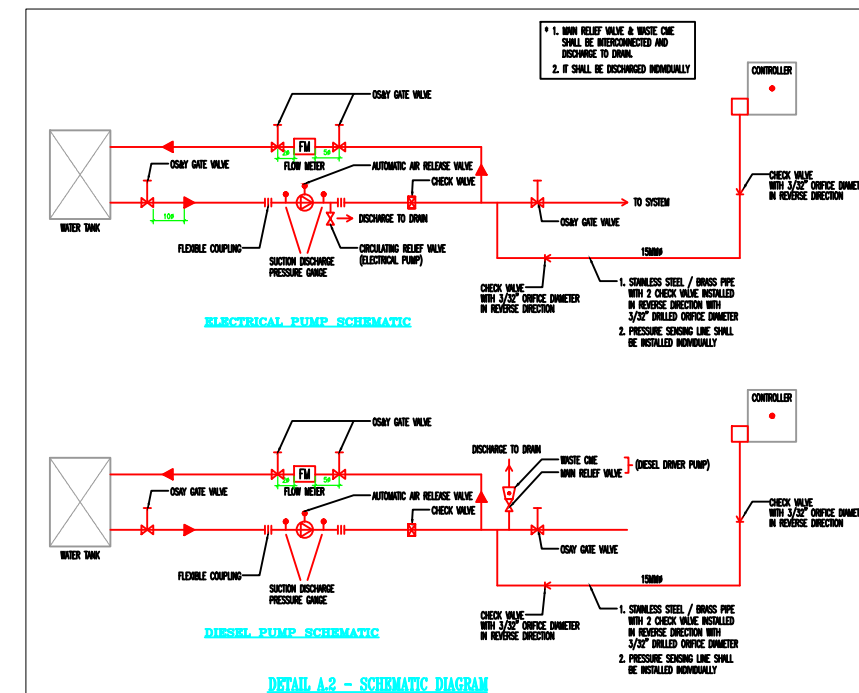

DETAIL A.2 - SCHEMATIC DIAGRAM

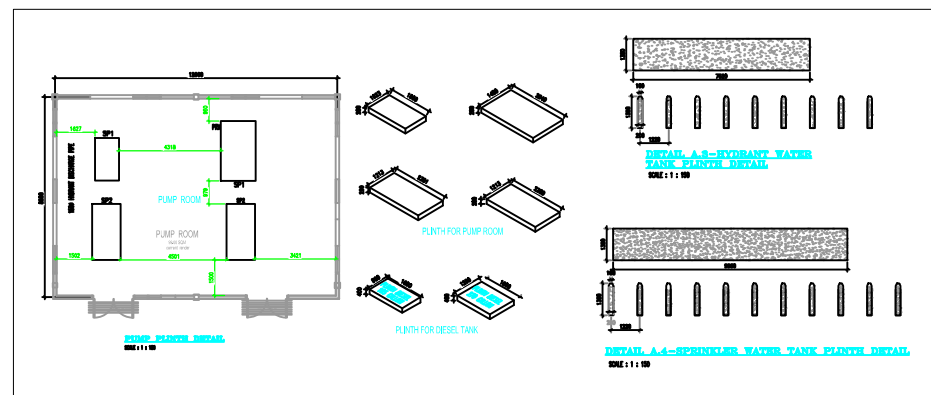

DETAIL A.3 - PUMP ROOM AND WATER TANK

AS-BUILT DRAWING

PROJECT TITLE :
 PROPOSED CONSTRUCTION & COMPLETION OF:
 PHASE 1 : 1-STORY WAREHOUSE (120m X 360m)
 WITH 2-STORY OFFICE / SOCIAL BLOCK
 INCLUDING
 a) 1 UNIT GUARD HOUSE
 b) 1 UNIT REFUSE CHAMBER
 c) 1 UNIT WASTE TREATMENT PLANT
 d) 1 UNIT PUMP HOUSE
 e) 1 UNIT TNB SUBSTATION

ON LOT 7316 (P.T. 3609),
 JALAN KLANG - BANTING,
 MUKIM TELUK PANGLIMA GARANG,
 KUALA LANGAT, SELANGOR

FOR RHB TRUSTEES BERHAD
 (AS TRUSTEE FOR AXIS REAL ESTATE INVESTMENT
 TRUST)

DEVELOPER :
 RHB TRUSTEES BERHAD
 (AS TRUSTEE FOR AXIS REIT)
 LEVEL 11, TOWER ONE,
 RHB CENTRE, JALAN TUN RAZAK,
 50400 KUALA LUMPUR, MALAYSIA.
 TEL: +603-9280 8799 FAX: +603-9280 8796

ARCHITECT :
 KOOI KEAT ARCHITECT
 No.18, Jalan Bukit Dandar, 11600 Penang, Malaysia.
 Tel: 04-629 9977 Fax: 04-656 8478
 info@kooi.com kooi@kooi.com

M & E CONSULTANT :
 FIG Fire Consultancy Sdn Bhd
 UNIT 12-4, 4TH FLOOR, JALAN 3/11A,
 KUCHAI BUSINESS CENTRE,
 OFF JALAN KUCHAI LAMA,
 58200 KUALA LUMPUR.
 TEL: 03-79842128 / 03-79842118
 FAX: 03-79842158

MAIN CONTRACTOR :
 AME CONSTRUCTION SDN BHD
 NO 18 JALAN ANGKASA MAS 6,
 KAWASAN PERINDUSTRIAN TEBRAU 2,
 81100 JOHOR BAHRU, JOHOR.
 TEL: 07- 355 5111
 FAX: 07- 3541648

FIRE FIGHTING CONTRACTOR :
 NATION FIRE ENGINEERING SDN BHD
 (653143-D)
 20, JALAN USJ 7/3A, UEP SUBANG JAYA,
 47610 SUBANG JAYA, SELANGOR DARUL OHSAN.
 TEL: 03-5621 0605/06 FAX: 03-5621 0615
 E-MAIL: nationfire@yahoo.com

FIRE PROTECTION SYSTEM
DRAWING TITLE :
 DETAIL A
 PUMP ROOM & WATER TANK

SCALE : AS SHOWN
DATE : DECEMBER 2017
DRAWING BY : FRANCISE KANG
CHECK BY : STEVEN
DRAWING NO : 3428/NF/FIG/2017/FF-DTL13