



DETAIL B.1-SPRINKLER ALARM VALVE DETAIL

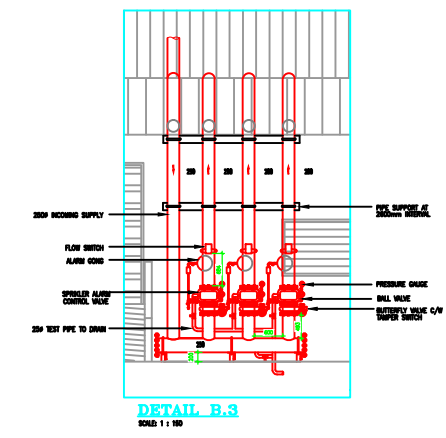

DETAIL B.3

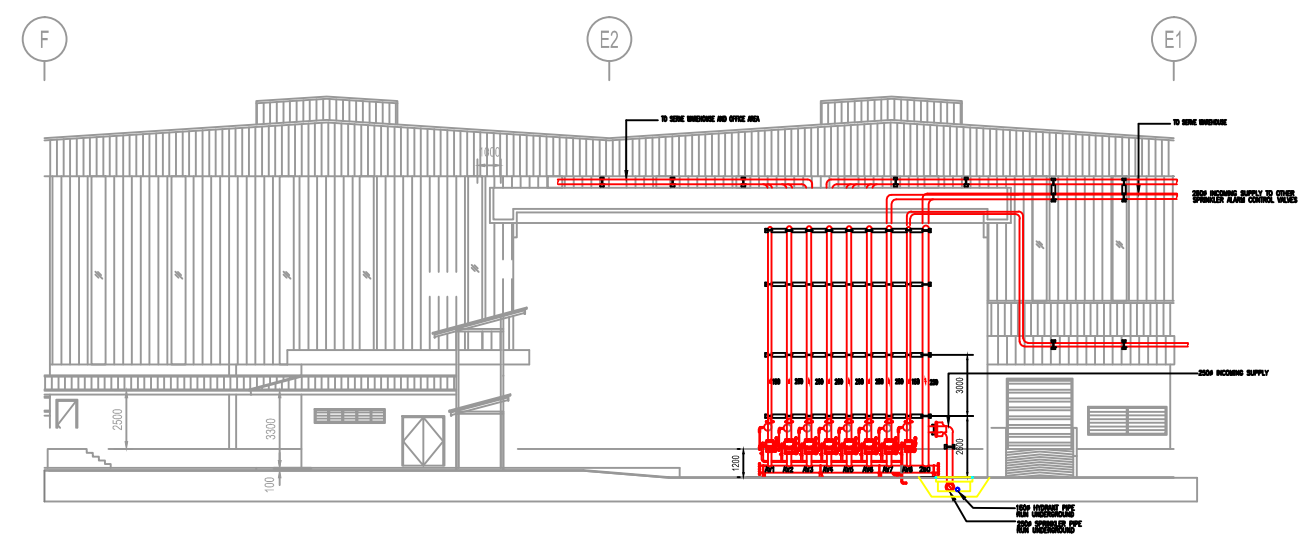

DETAIL B.2-SPRINKLER ALARM VALVE DETAIL


**PROJECT TITLE :**  
 PROPOSED CONSTRUCTION & COMPLETION OF:  
 PHASE 1 : 1-STORY WAREHOUSE (120m X 360m)  
 WITH 2-STORY OFFICE / SOCIAL BLOCK  
 INCLUDING  
 a) 1 UNIT GUARD HOUSE  
 b) 1 UNIT REFUSE CHAMBER  
 c) 1 UNIT WASTE TREATMENT PLANT  
 d) 1 UNIT PUMP HOUSE  
 e) 1 UNIT TNB SUBSTATION  
 ON LOT 7316 (P.T. 3609),  
 JALAN KLANG - BANTING,  
 MUKIM TELUK PANGLIMA GARANG,  
 KUALA LANGAT, SELANGOR  
 FOR RHB TRUSTEES BERHAD  
 (AS TRUSTEE FOR AXIS REAL ESTATE INVESTMENT  
 TRUST)

**DEVELOPER :**  
 RHB TRUSTEES BERHAD  
 (AS TRUSTEE FOR AXIS REIT)  
 LEVEL 11, TOWER ONE,  
 RHB CENTRE, JALAN TUN RAZAK,  
 50400 KUALA LUMPUR, MALAYSIA.  
 TEL: +603-9280 8799 FAX: +603-9280 8796

**ARCHITECT :**  
  
 KOOI KEAT ARCHITECT  
 no.18, taman built dumbur, 11600 penang, malaysia.  
 Tel:04-659 9997 Fax:04-656 8478  
 emskool@kooikeat.com.my

**M & E CONSULTANT :**  
  
 UNIT 12-4, 4TH FLOOR, JALAN 3/114,  
 KUCHAI BUSINESS CENTRE,  
 OFF JALAN KUCHAI LAMA,  
 58200 KUALA LUMPUR.  
 TEL: 03-79842128 / 03-79842118  
 FAX: 03-79842158

**MAIN CONTRACTOR :**  
 AME CONSTRUCTION SDN BHD  
 NO 18 JALAN ANGKASA MAS 6,  
 KAWASAN PERINDUSTRIAN TEBRAU 2,  
 81100 JOHOR BAHRU, JOHOR.  
 TEL: 07- 355 5111  
 FAX: 07- 3541648

**FIRE FIGHTING CONTRACTOR :**  
  
 NATION FIRE ENGINEERING SDN BHD  
 (63143-D)  
 20, JALAN USJ 7/3A, UEP SUBANG JAYA,  
 47610 SUBANG JAYA, SELANGOR DARUL EHSAN.  
 TEL: 03-5621 0605/06 FAX: 03-5621 0615  
 E-MAIL: nationfire@yahoo.com

**FIRE PROTECTION SYSTEM**  
 DRAWING TITLE :  
 DETAIL B  
 -DETAIL OF ALARM VALVE INSTALLATION

SCALE : 1:150  
 DATE : DECEMBER 2017  
 DRAWING BY : FRANCIESE KANG  
 CHECK BY : STEVEN  
 DRAWING NO : 3428/NF/FIG/2017/FF- DTL14

AS-BUILT DRAWING