



DETAIL C.2-SPRINKLER MAIN PIPE SUPPORT (GRID LINE A1-F)
SCALE : 1:20

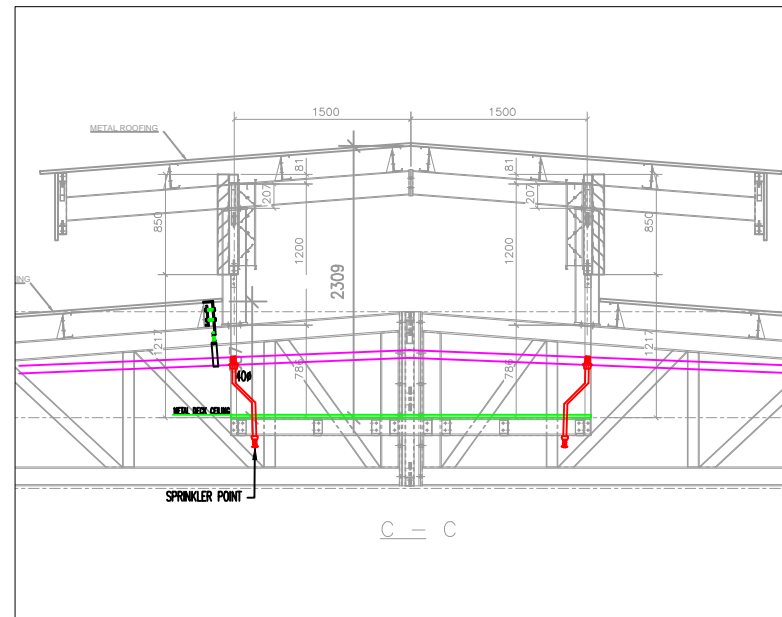

DETAIL C.3-SPRINKLER AT JACKROOF WITH CEILING

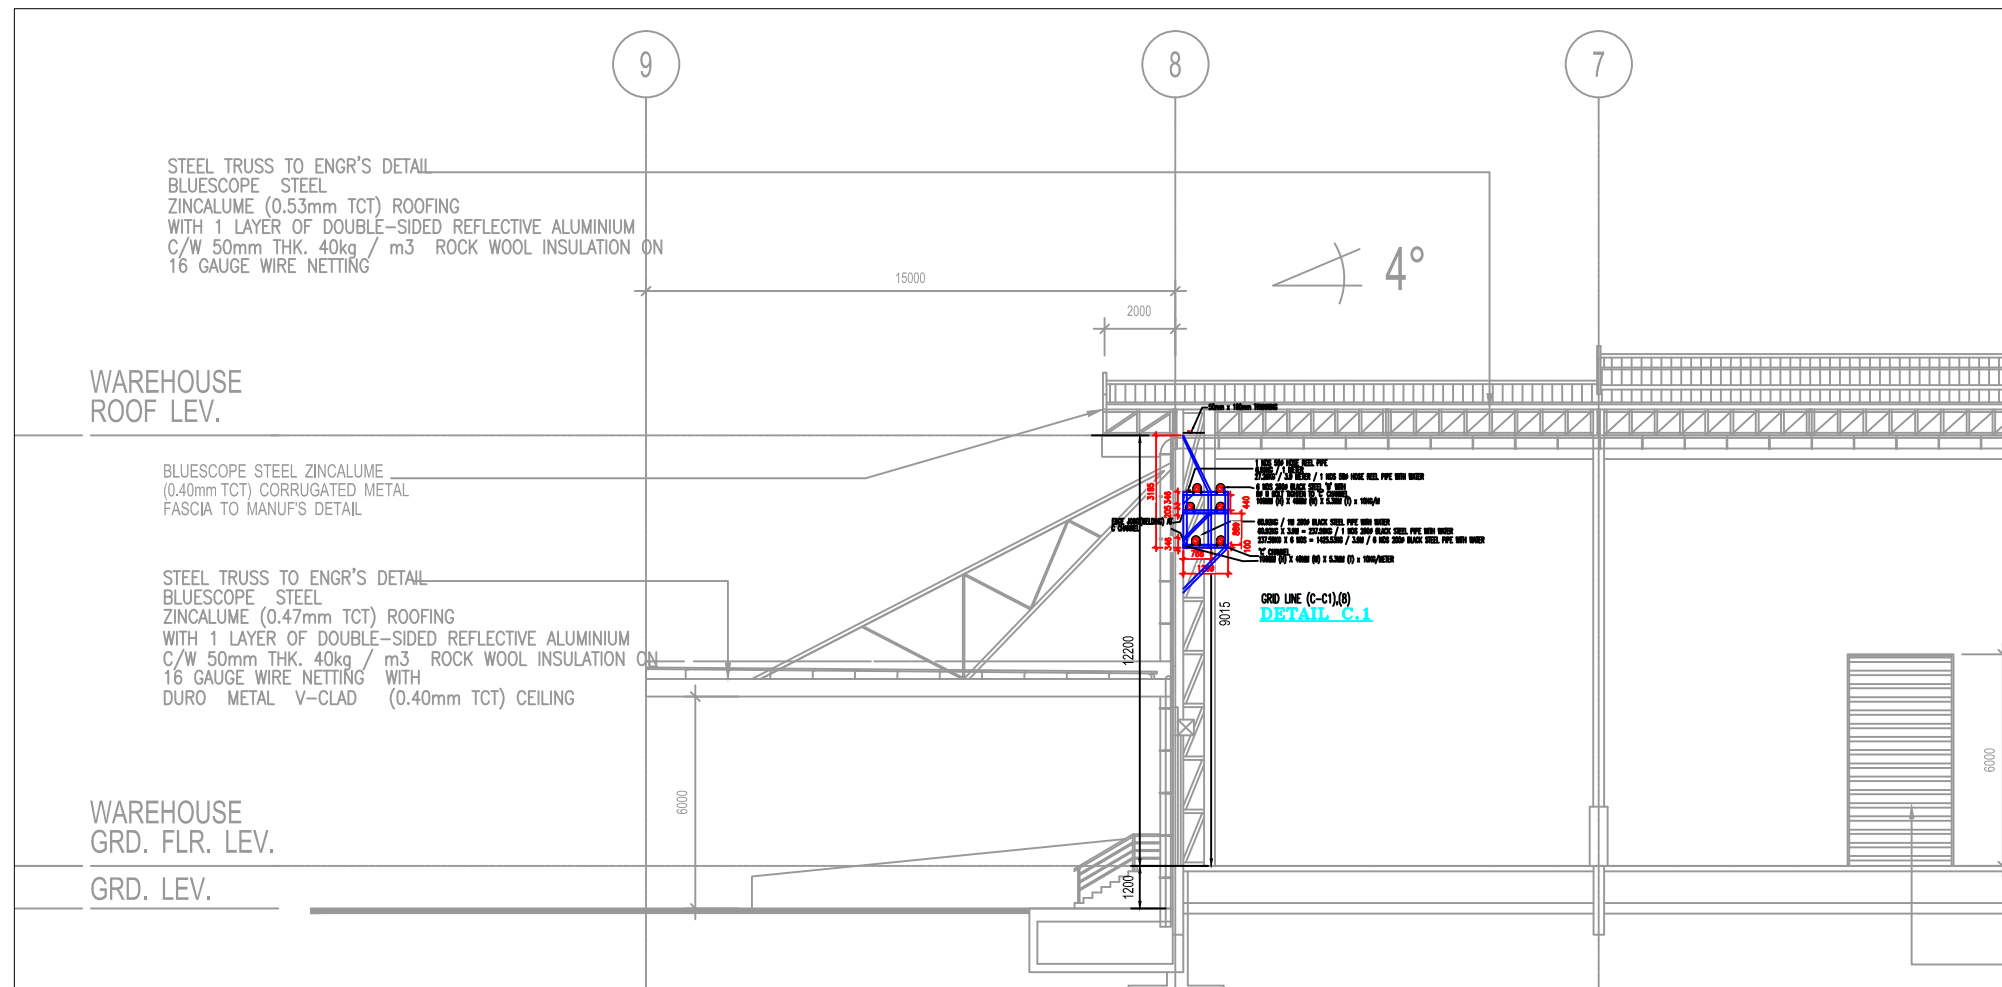

DETAIL C-SPRINKLER MAIN PIPE SUPPORT
SCALE : 1:100

PROJECT TITLE :
PROPOSED CONSTRUCTION & COMPLETION OF:
PHASE 1 : 1-STOREY WAREHOUSE (120m X 360m)
WITH 2-STOREY OFFICE / SOCIAL BLOCK
INCLUDING
a) 1 UNIT GUARD HOUSE
b) 1 UNIT REFUSE CHAMBER
c) 1 UNIT WASTE TREATMENT PLANT
d) 1 UNIT PUMP HOUSE
e) 1 UNIT TNB SUBSTATION

ON LOT 7316 (P.T. 3609),
JALAN KLANG - BANTING,
MUKIM TELUK PANGLIMA GARANG,
KUALA LANGAT, SELANGOR

FOR RHB TRUSTEES BERHAD
(AS TRUSTEE FOR AXIS REAL ESTATE INVESTMENT TRUST)

DEVELOPER :

RHB TRUSTEES BERHAD
(AS TRUSTEE FOR AXIS REIT)
LEVEL 11, TOWER ONE,
RHB CENTRE, JALAN TUN RAZAK,
50400 KUALA LUMPUR, MALAYSIA.
TEL: +603-9280 8799 FAX: +603-9280 8796

ARCHITECT :

KOOI KEAT ARCHITECT
no.18, taman bakti dumbur, 11600 penang, malaysia.
Tel:04-659 9997 Fax:04-656 8478
enquiries@kooikeat.com.my

M & E CONSULTANT :

FIG FIG Consultancy Sdn Bhd
Fire Safety Engineering

UNIT 12-4, 4TH FLOOR, JALAN 3/114,
KUCHAI BUSINESS CENTRE,
OFF JALAN KUCHAI LAMA,
58200 KUALA LUMPUR.
TEL: 03-79842128 / 03-79842118
FAX: 03-79842158

MAIN CONTRACTOR :

AME CONSTRUCTION SDN BHD
NO 18 JALAN ANGKASA MAS 6,
KAWASAN PERINDUSTRIAN TEBRAU 2,
81100 JOHOR BAHRU, JOHOR.
TEL: 07- 355 5111
FAX: 07- 3541648

FIRE FIGHTING CONTRACTOR :

NATION FIRE ENGINEERING SDN BHD
(653143-D)
20, JALAN USJ 7/3A, UEP SUBANG JAYA,
47610 SUBANG JAYA, SELANGOR DARUL EHSAN.
TEL: 03-5621 0605/06 FAX: 03-5621 0615
E-MAIL: nationfire@yahoo.com

FIRE PROTECTION SYSTEM

DRAWING TITLE :

DETAIL C

-DETAIL OF SPRINKLER MAIN PIPE SUPPORT

SCALE : AS SHOWN

DATE : DECEMBER 2017

DRAWING BY : FRANCISE KANG

CHECK BY : STEVEN

DRAWING NO :

3428/NF/FIG/2017/FF- DTL15

AS-BUILT DRAWING