


AS-BUILT DRAWING

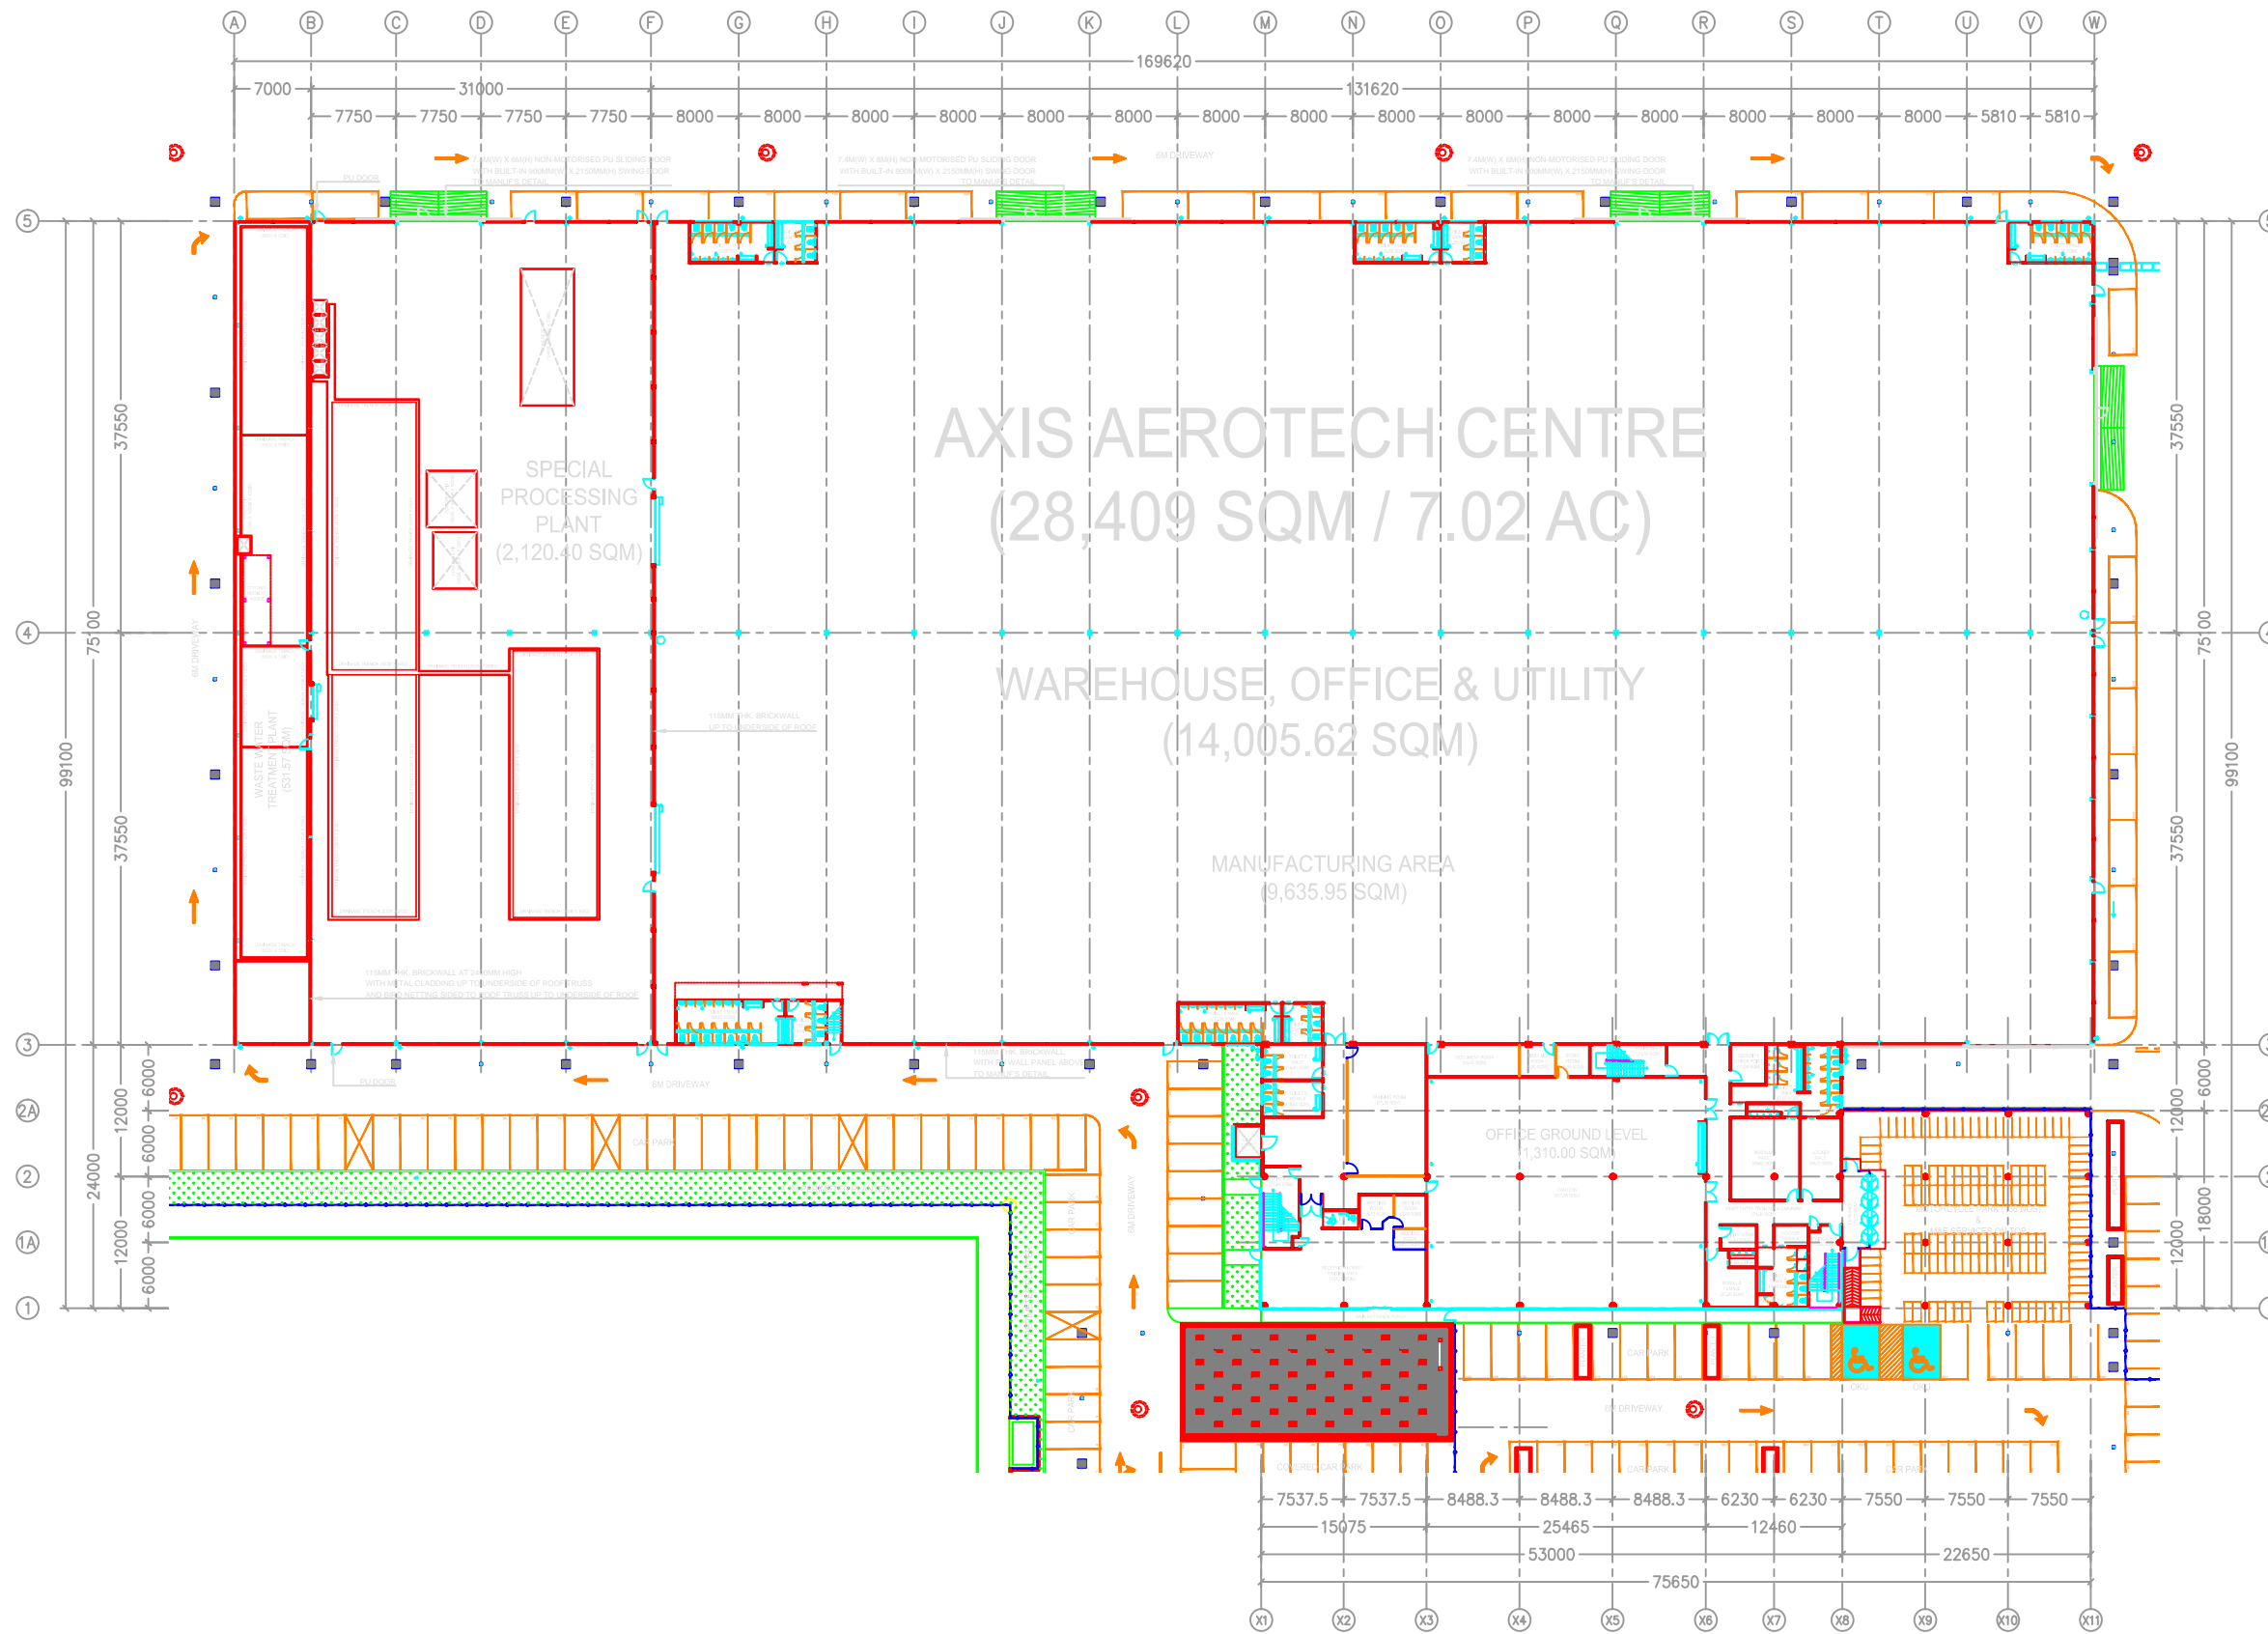

**PROJECT TITLE**  
PROPOSED CONSTRUCTION & COMPLETION OF:  
AXIS AEROTECH CENTRE  
1-STORY WAREHOUSE WITH 3-STORY OFFICE & UTILITY  
INCLUDING

- a) 1 UNIT GUARD HOUSE
- b) 1 UNIT REFUSE DEPO
- c) 1 UNIT PUMP HOUSE
- d) 1 UNIT ELEVATED WATER TANK

**ON**  
LOT 1210, SEKSYEN U3,  
40150 MUKIM DAMANSARA,  
DAERAH PETALING,  
SELANGOR DARUL EHSAN.

**FOR RHB TRUSTEES BERHAD**  
(AS TRUSTEE FOR AXIS REAL ESTATE INVESTMENT TRUST)

**DEVELOPER**  
**RHB** RHB TRUSTEES BERHAD  
(AS TRUSTEE FOR AXIS REIT)  
LEVEL 11, TOWER ONE,  
RHB CENTRE, JALAN TUN RAZAK,  
50400 KUALA LUMPUR, MALAYSIA.  
TEL: +603-9280 8799 FAX: +603-9280 8796

**ARCHITECT**  
**KOOI KEAT ARCHITECT**  
NO.19, TAMAN BUKIT DUMBER,  
11600 PENANG.  
TEL: +604-659 9987 FAX: +604-658 8478  
EMAIL: kooikeat@kooikeatarchitect.com.my

**CIVIL & STRUCTURAL ENGINEER**  
**WK & PARTNERS CONSULT SDN BHD**  
NO.C-8-1, PUTRA WALK, JALAN PP 25,  
TAMAN PINGGIRAN PUTRA,  
43300 SERI KEMBANGAN, SELANGOR.  
TEL: +603-8959 7022  
EMAIL: wknpc@wknpc.com WEB: www.wknpc.com

**MECHANICAL & ELECTRICAL ENGINEER**  
**HAN YANG CONSULTANCY SDN BHD**  
12-B, MEDAN ANGSANA 2,  
11500 BANDAR BARU AYER ITAM, PULAU PINANG.  
TEL: +604-829 4489 FAX: +604-829 2289  
EMAIL: hanyang.sdn.bhd@gmail.com

**QUANTITY SURVEYOR**  
**PERUNDING KOS CSS**  
NO.47 & 49-1 & 2, JALAN 1/62D,  
BANDAR MENJALARA,  
52200 KUALA LUMPUR.  
TEL: +603-6276 9823 FAX: +603-6276 3672  
EMAIL: pkcss@streamyx.com

**CONTRACTOR**  
**AME CONSTRUCTION SDN BHD**  
NO.15, JALAN I-PARK SAC 2,  
TAMAN PERINDUSTRIAN I-PARK SAC,  
81400 SENAI, JOHOR.  
TEL: +607-5959 666 FAX: +607-5959 668  
WEB: www.ameconstruction.com.my

**DRAWING TITLE**  
**GROUND FLOOR PLAN**

**DRAWING NUMBER**

SCALE	1:1	DATE	JAN 2019
DRAWN	AMECSB	CHECKED	AMECSB