
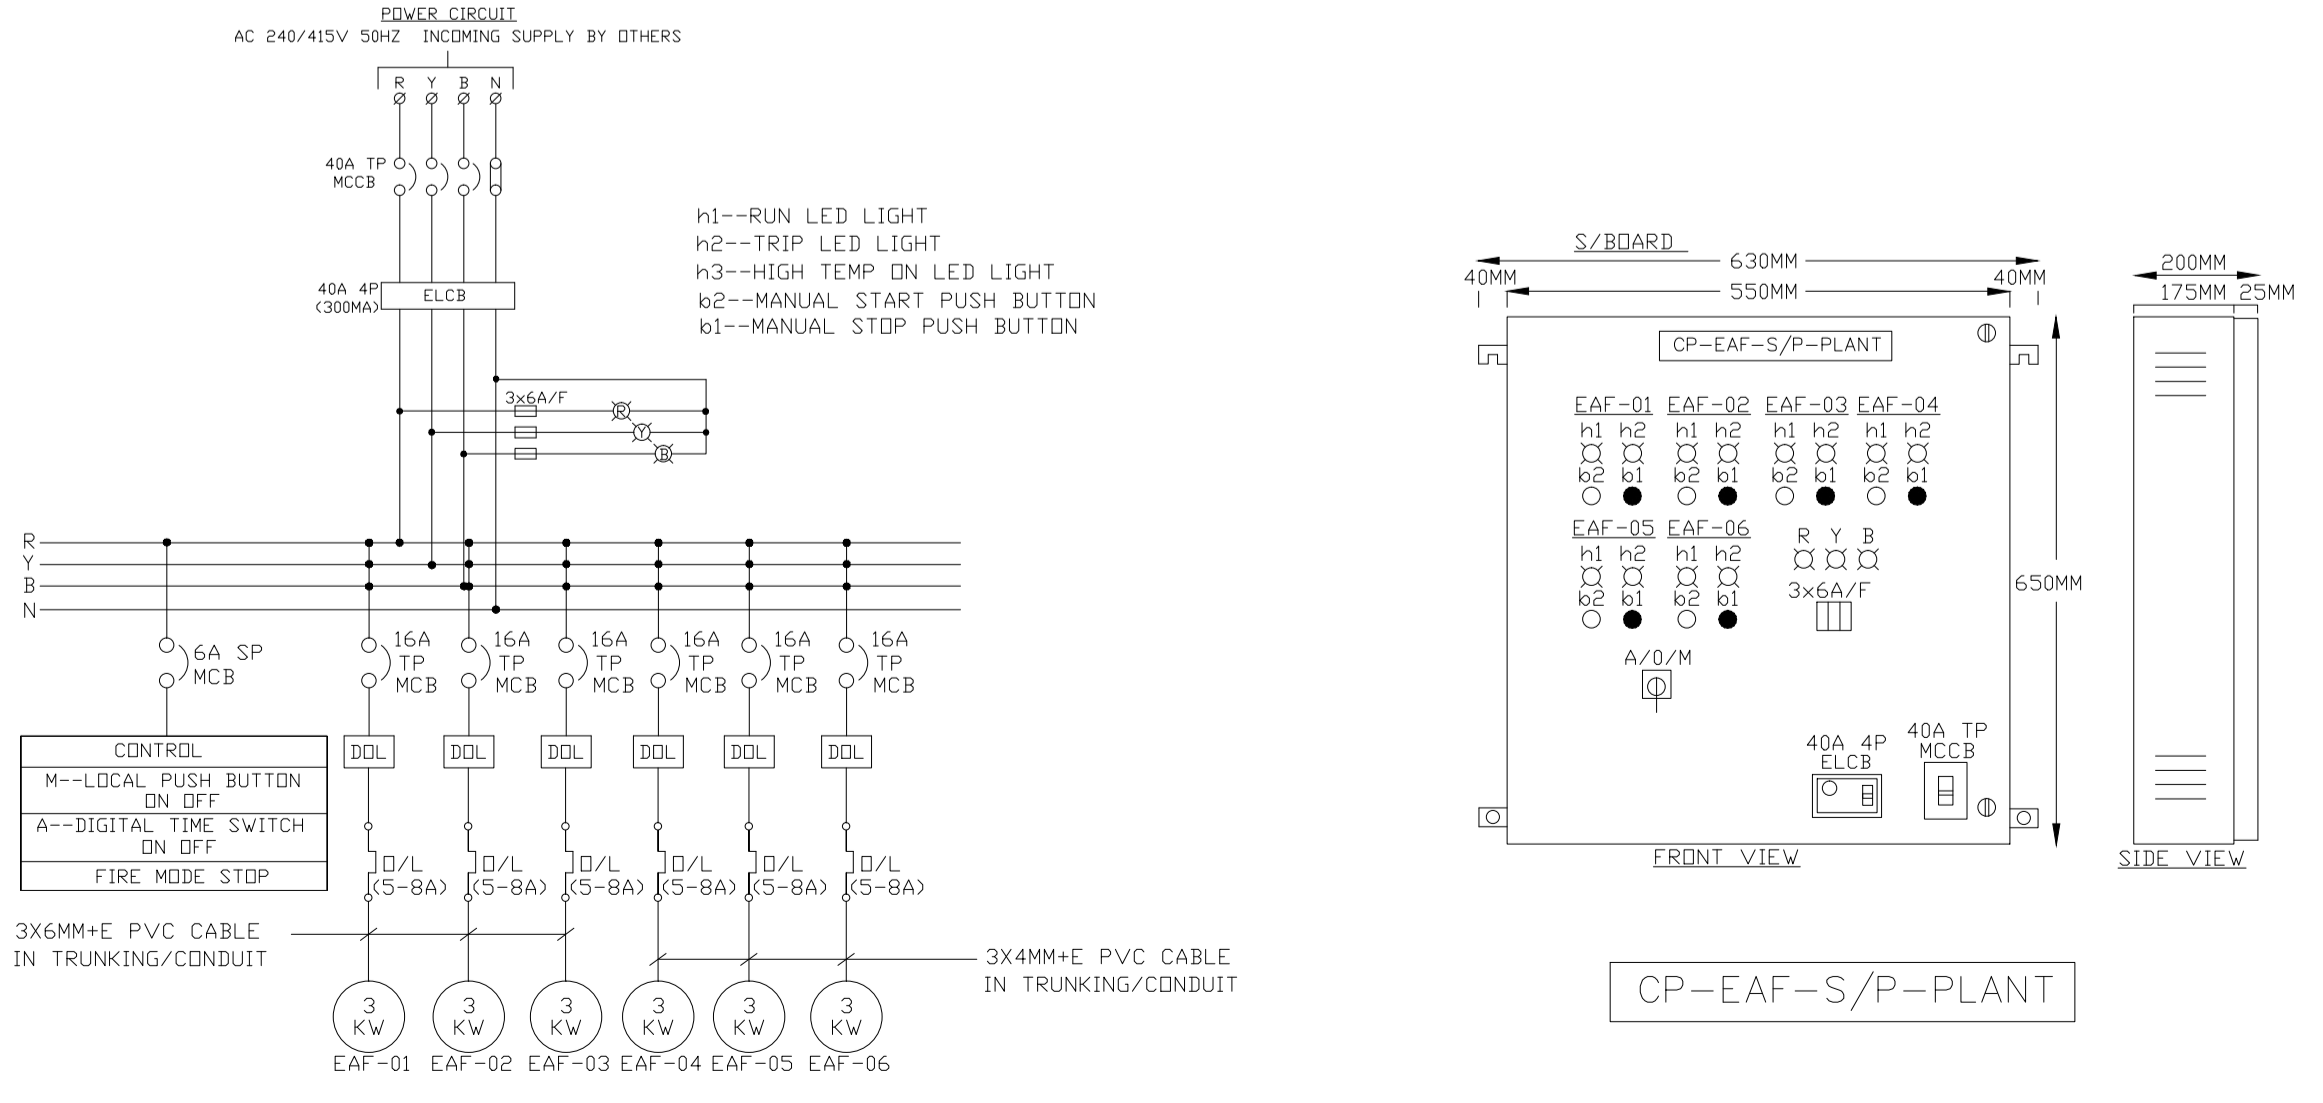


LEGEND			
SYMBOL	DESCRIPTION	BRAND	ORIGINAL COUNTRY
S/B/M/T	SWITCH BOARD METAL THICKNESS (1.5MM)	FLOOR STANDING	MALAYSIA
P/C	POWER COATING	DXPLAST	MALAYSIA
COLOR	FF-160/85B/CW25 (LIGHT GREY)	DXPLAST	MALAYSIA
MCCB	MOULDED CASE CIRCUIT BREAKER	SCHNEIDER	FRANCE
MCB	MINIATURE CIRCUIT BREAKER	SCHNEIDER	FRANCE
DPM	DIGITAL POWER METER	SCHNEIDER	FRANCE
D-T/S	DIGITAL TIME SWITCH	ANLY	TAIWAN
C/T	AMP CURRENT TRANSFORMER	ASAHI	MALAYSIA
C/R & F/R	CONTROL & FIRE RELAY	SCHNEIDER	FRANCE

CP-SSF-MA-01 to 15
&
SAF-MA-01 to 06

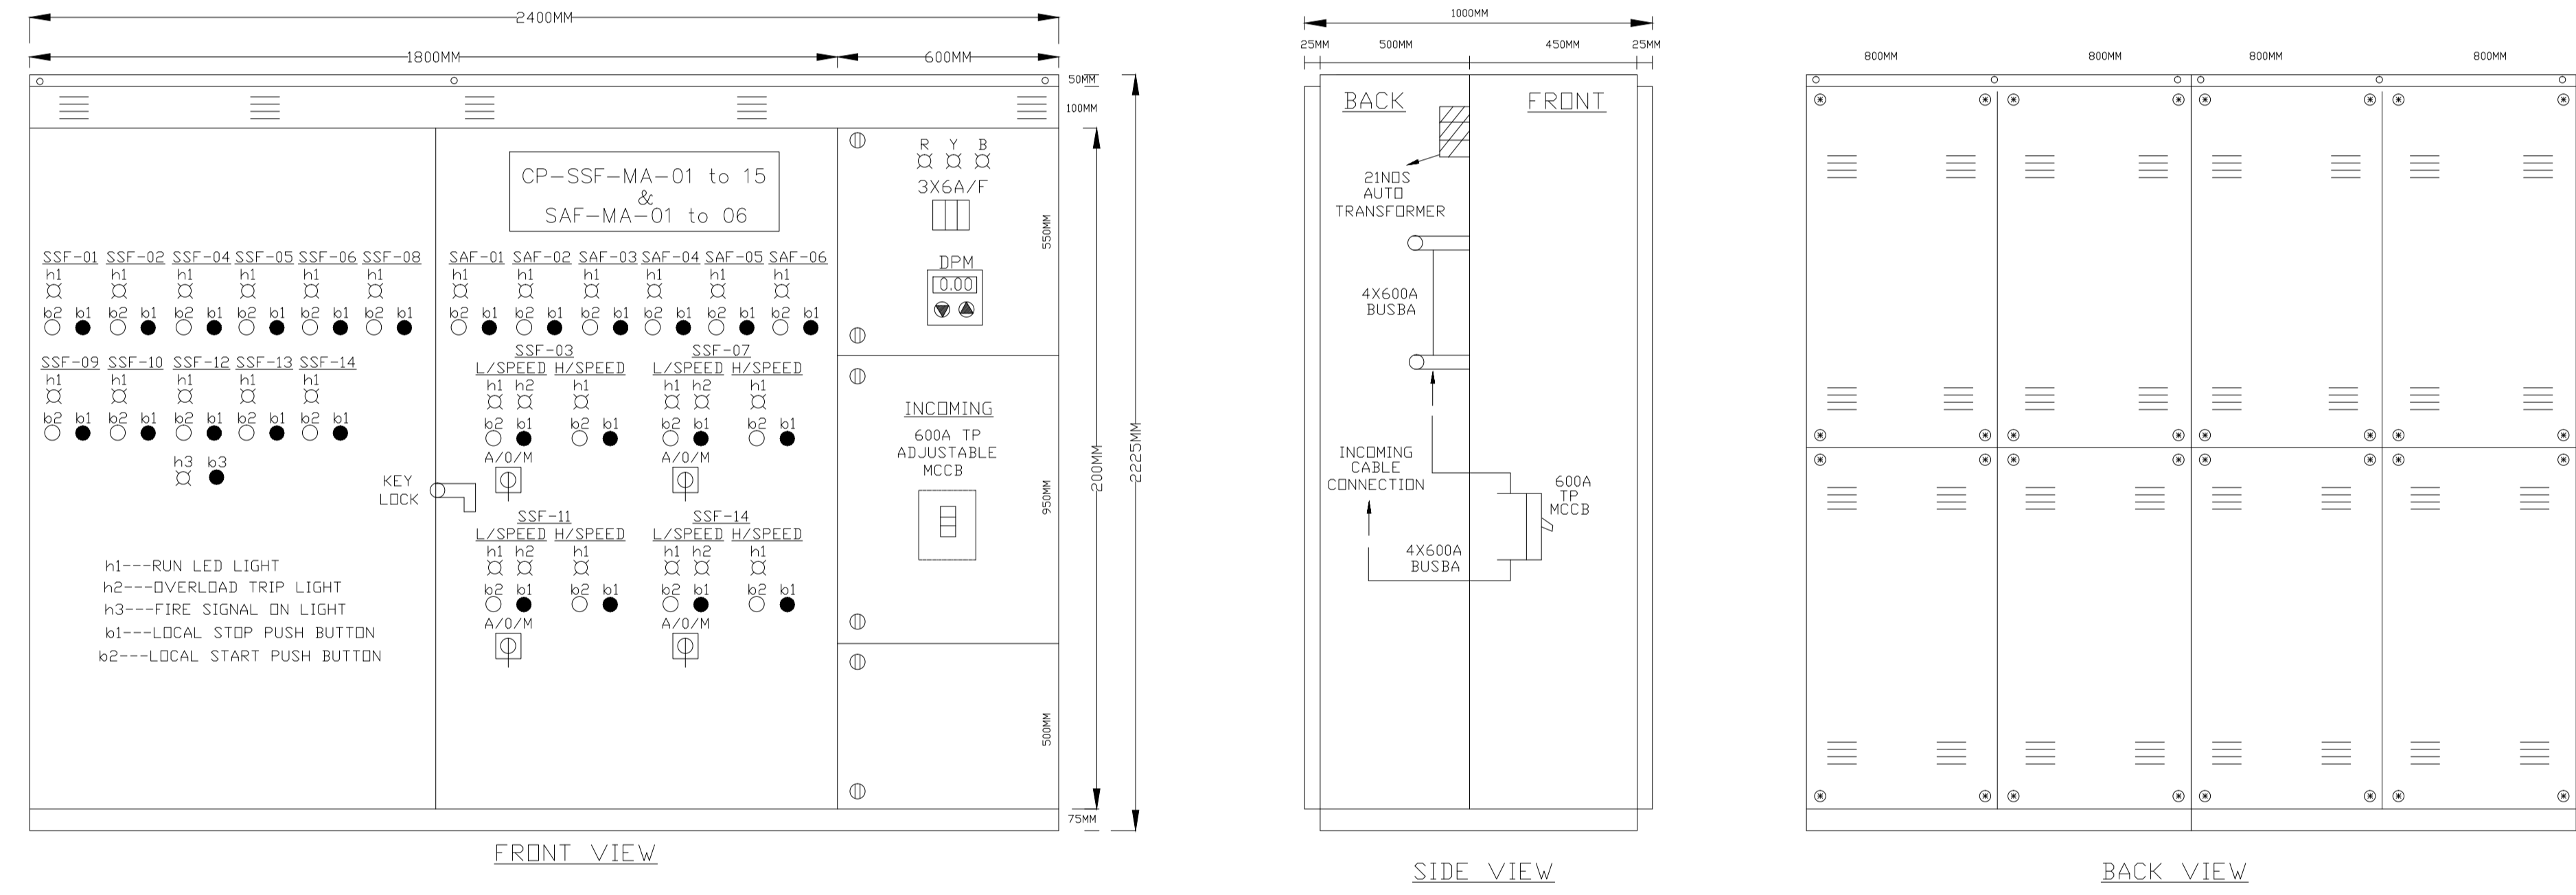

LEGEND			
SYMBOL	DESCRIPTION	BRAND	ORIGINAL COUNTRY
S/B/M/T	SWITCH BOARD METAL THICKNESS (1.5MM)	WALL MOUNTED	MALAYSIA
P/C	POWER COATING	DXPLAST	MALAYSIA
COLOR	FF-160/85B/CW25 (LIGHT GREY)	DXPLAST	MALAYSIA
MCCB	MOULDED CASE CIRCUIT BREAKER	SCHNEIDER	FRANCE
MCB	MINIATURE CIRCUIT BREAKER	SCHNEIDER	FRANCE
D/L	DIRECT ON LINE CONTACTOR	SCHNEIDER	FRANCE
ELCB	EARTH LEAKAGE CIRCUIT BREAKER	SCHNEIDER	FRANCE
D-T/S	DIGITAL TIME SWITCH	ANLY	TAIWAN
C/R & F/R	CONTROL & FIRE RELAY	SCHNEIDER	FRANCE

AS-BUILT DRAWING

NOTICE

This drawing and all information thereon is the property of HVAR engineering services sdn. bhd. No.5A & 5B, Jalan Sepadu A25/A, Taman Perindustrian Axis, Seksyen 25, 40400 Shah Alam, Selangor Darul Ehsan. Tel :- 03-51248218 Fax :- 03-51248219/20

This drawing and all information thereon is confidential and must not be made public, copied or used to disadvantage of said HVAR engineering services sdn. bhd. It is subject to return on demand.

Notes :

Owner :

RHB
RHB Trustees Berhad
RHB TRUSTEES BERHAD (573019-U)
(As Trustee for Axis Real Estate Investment Trust)
TINGKAT 11, TOWER ONE,
RHB CENTRE, JALAN TUN RAZAK,
50400 KUALA LUMPUR
WILAYAH PERSEKUTUAN KUALA LUMPUR.
Tel: +603 9280 8799 Fax: +603 9280 8796

Consulting Engineers :

HAN YANG CONSULTANCY SDN BHD
MECHANICAL & ELECTRICAL CONSULTING ENGINEERS
12-B, Medan Angsana 2,
11500 Bandar Baru Ayer Itam,
Pulau Pinang.
Tel: 04-8294489 Fax: 04-8292289
E-mail: hanyang.sdn.bhd@gmail.com

Architect:

KOO I KEAT ARCHITECT
no.19, taman bukit dumar, 11600 penang, malaysia.
tel: 04-659 9887 fax: 04-656 8476 e-mail: kooikeat@kooikeatarchitect.com.my

Main Contractor :

AME
- CONSTRUCTION -
AME CONSTRUCTION SDN BHD
NO. 18, JALAN ANGKASA MAS 6
KAWASAN PERINDUSTRIAN TEBRAU 2
81100 JOHOR BAHRU, JOHOR
TEL: 07-3555111 FAX: 07-3541648
EMAIL: info@ameconstruction.com.my
WEBSITE: www.ameconstruction.com.my

Air-Conditioning Contractor :

HVAR engineering services sdn. bhd.
No.5A & 5B, Jalan Sepadu A25/A,
Taman Perindustrian Axis, Seksyen
25, 40400 Shah Alam, Selangor.
Tel :- 03-51248218
Fax :- 03-51248219/20
Email: hvarengineering@yahoo.com
hvar1979@gmail.com
Air Conditioning Is Our Business Since 1979

Project Name :

**CADANGAN PEMBANGUNAN KILANG
PENGELUARAN KOMPONEN KAPAL TERBANG 1
TINGKAT DAN PEJABAT 3 TINGKAT DI ATAS
SEBAGIAN LOT 1210, SEKSYEN U3, 40150
MUKIM DAMANSARA, DAERAH PETALING,
SELANGOR DARUL EHSAN.
UNTUK TIUAN :
RHB TRUSTEES BERHAD
(As Trustee for Axis Real Estate Investment Trust)**

Subject :

Smokespill Switchboard & Power Circuit For
Special Processing Plant & Manufacturing Area

Checked By : Charlie

Designed By : Charlie

Drawn By : Siti

Date : 05/12/18 Job Ref : 034-2018-AXIS-SA

Scale : N.T.S.

Drawing No: HES/AXIS/SA/034/03/18-CP-SSF-EAF(ABD)