
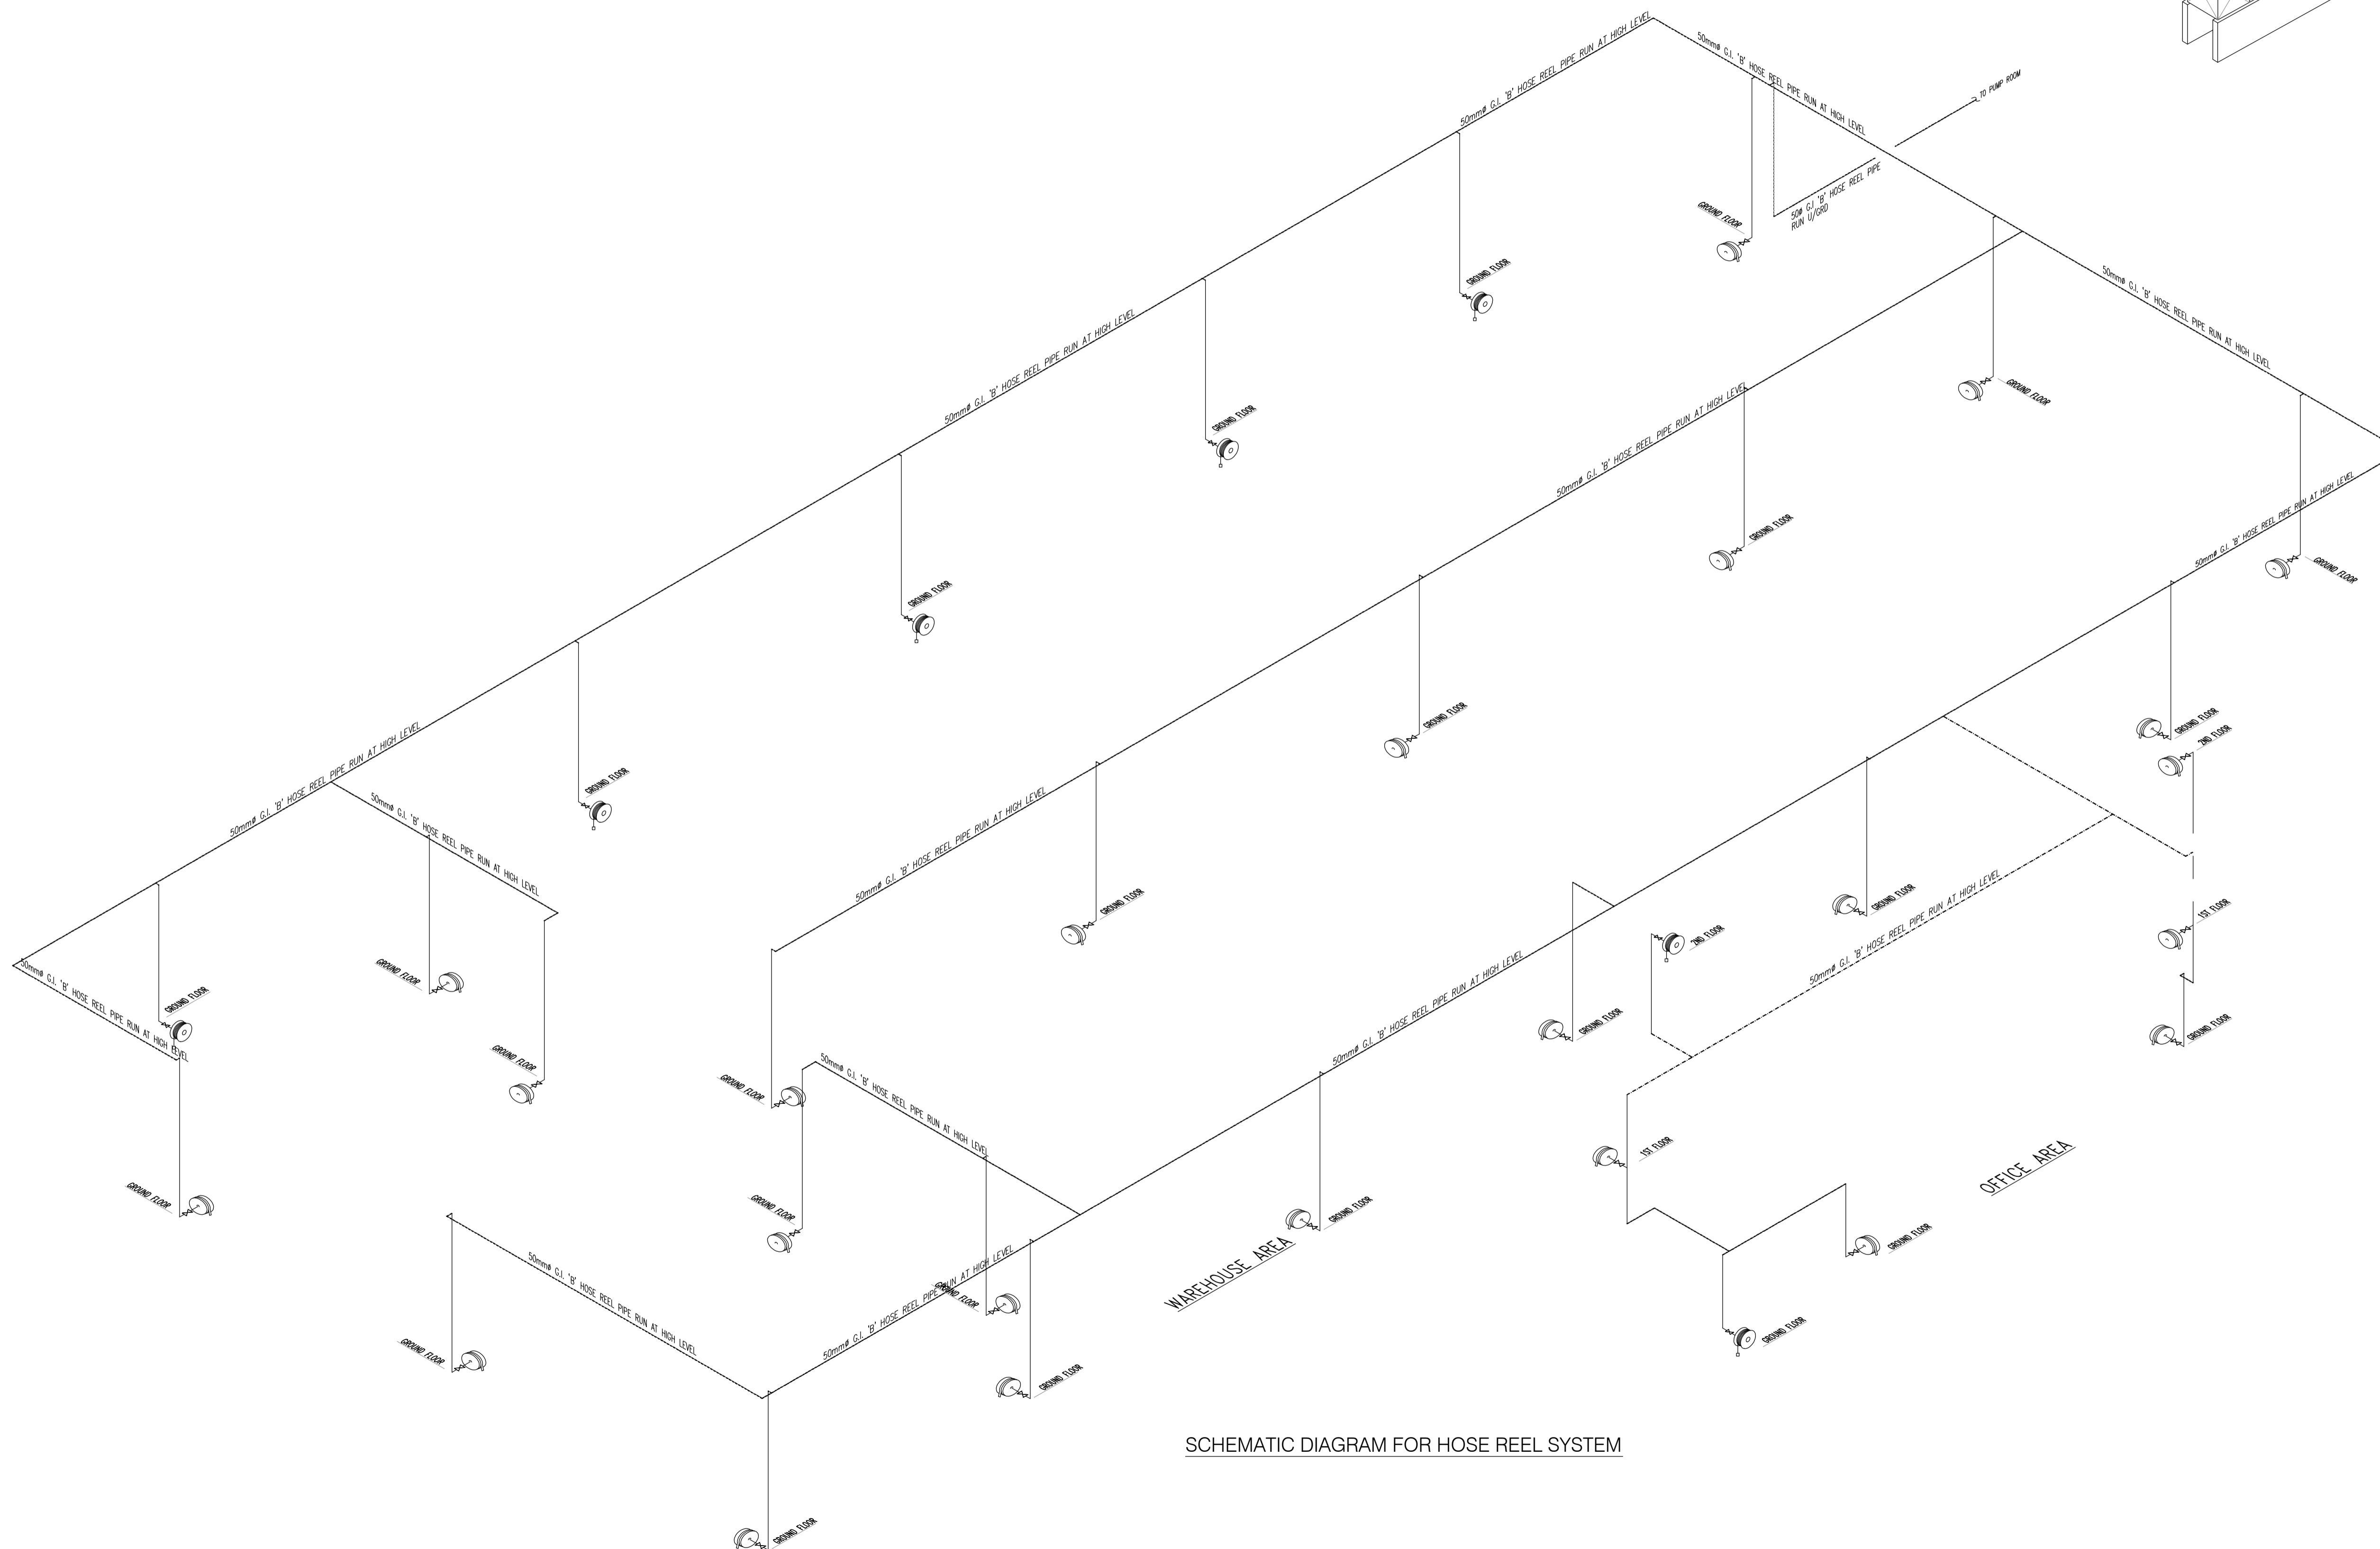


HOSE REEL WATER TANK  
 GALVANISED PRESSED STEEL  
 4880 x 1220 x 2440 (H)  
 NORMATINAL CAP: 3,200 GAL.  
 EFF.CAP: 2,880 GAL.

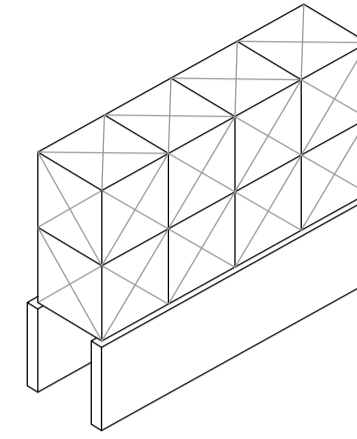

SCHMATIC DIAGRAM FOR HOSE REEL SYSTEM

AS-BUILT DRAWING

TAJUK PROJEK :

**PERMOHONAN KEBENARAN MERANCANG  
 PENDIRIAN BANGUNAN BAGI CADANGAN  
 PEMBANGUNAN KILANG PENGELUARAN  
 KOMPONEN KAPAL TERBANG DI ATAS  
 SEBAHAGIAN LOT 1210, SEKSYEN U3, 40150  
 MUKIM DAMANSARA, DAERAH PETALING,  
 SELANGOR DARUL EHSAN.**

**UNTUK TETUAN :**  
**RHB TRUSTEES BERHAD**  
**(As Trustee for Axis Real Estate Investment Trust)**

PEMILIK TANAH :

**MALAYSIA AIRPORTS HOLDING BERHAD**  
 (MAHB) (48792-W)  
 MALAYSIA AIRPORTS CORPORATE OFFICE,  
 PERSIARAN KORPORAT KLIA,  
 64000 KLIA, SEPANG,  
 SELANGOR DARUL EHSAN  
 Tel: +603 8777 7000 Fax: +603 8777 7580

PEMILIK BANGUNAN :

**RHB TRUSTEES BERHAD** (573019-U)  
 (As Trustee for Axis Real Estate Investment Trust)  
 RHB Trustees Berhad  
 TINGKAT 11, TOWER ONE,  
 RHB CENTRE, JALAN TUN RAZAK,  
 60400 KUALA LUMPUR,  
 WILAYAH PERSEKUTUAN KUALA LUMPUR.  
 Tel: +603 9280 8799 Fax: +603 9280 8796

T.T. ARKITEK :

**KOOI KEAT ARCHITECT**  
 no.19, taman bukit dumar, 11600 penang, malaysia.  
 tel: 04-659 9987 fax: 04-656 8478 e-mail: kooikeat@kooikeatarchitect.com.my

**Ar. Ooi Kooi Keat**  
 ARKITEK  
 No. Pendaftaran LAM : A/O 61

MAIN CONTRACTOR :

**AME CONSTRUCTION SDN BHD**  
 NO 18 JALAN ANGKASA MAS 6,  
 KAWASAN PERINDUSTRIAN TEBRAU 2,  
 81100 JOHOR BAHRU, JOHOR.  
 TEL: 07- 355 5111  
 FAX: 07- 3541648

PERUNDING M & E :

**HAN YANG CONSULTANCY SDN BHD**  
 MECHANICAL & ELECTRICAL CONSULTING ENGINEERS  
 Tingkat 1, No. 19, Lorong Desa Pauh 1,  
 Taman Desa Pauh, 13700 Perai,  
 Pulau Pinang.  
 Tel: 04-3979100 Fax: 04-3979101  
 E-mail : hanyang.sdn.bhd@gmail.com

FIRE CONTRACTOR :

**NATION FIRE ENGINEERING SDN BHD**  
 (453143-D)  
 20, JALAN USJ 7/3A, UEP SUBANG JAYA,  
 47610 SUBANG JAYA, SELANGOR DARUL EHSAN.  
 TEL: 03-5621 0805/06 FAX: 03-5621 0815  
 E-MAIL: nationfire@yahoo.com

**FIRE PROTECTION SYSTEM**

TAJUK LUKISAN:

SCHMATIC DIAGRAM FOR HOSE REEL SYSTEM

SCALE :	N.T.S
DATE :	JANUARY 2019
DRAWING BY :	FRANCIESE KANG
CHEK BY :	STEVEN
DRAWING NO :	3445/NF/AAC/2018-FF09