




PUMP ROOM
SCALE : 1:50

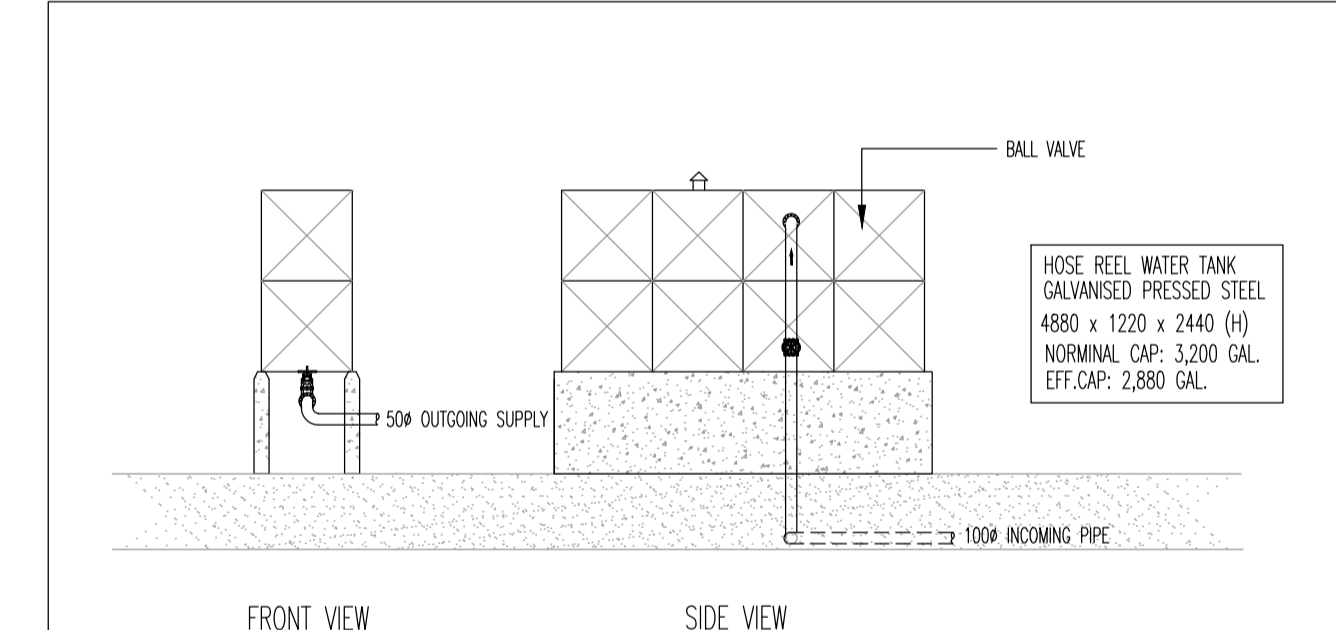

HOSE REEL TANK
SCALE : 1:100

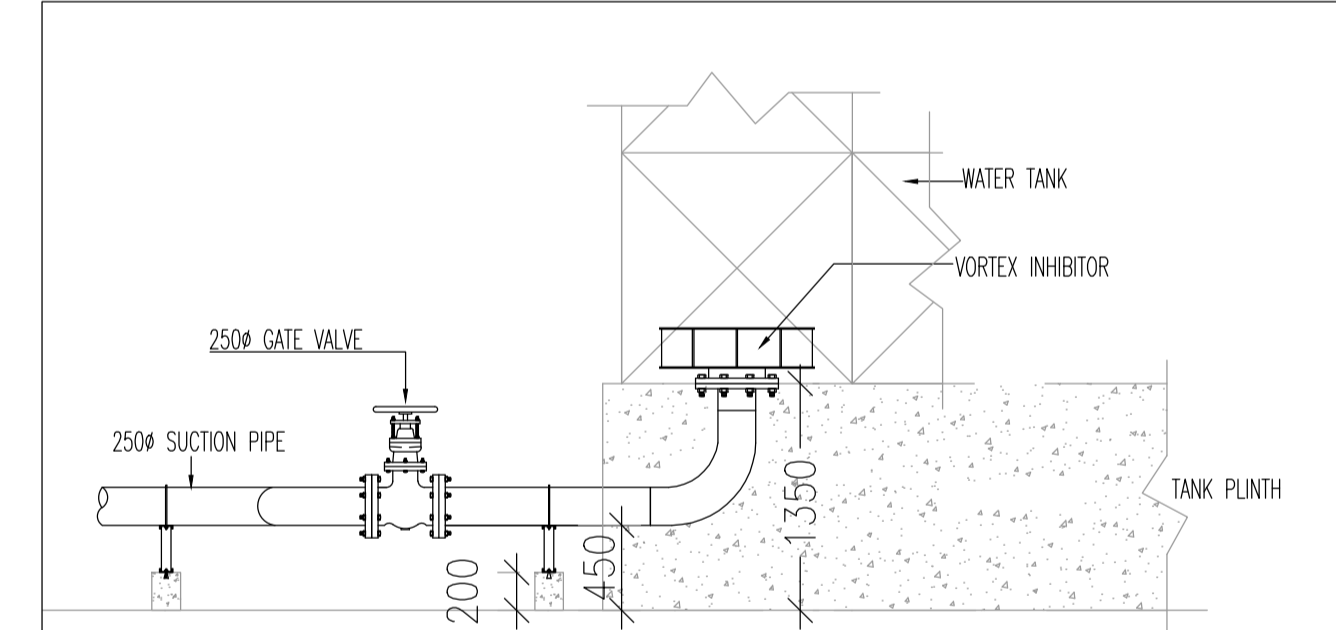

DETAIL - GATE VALVE
SCALE : 1:40

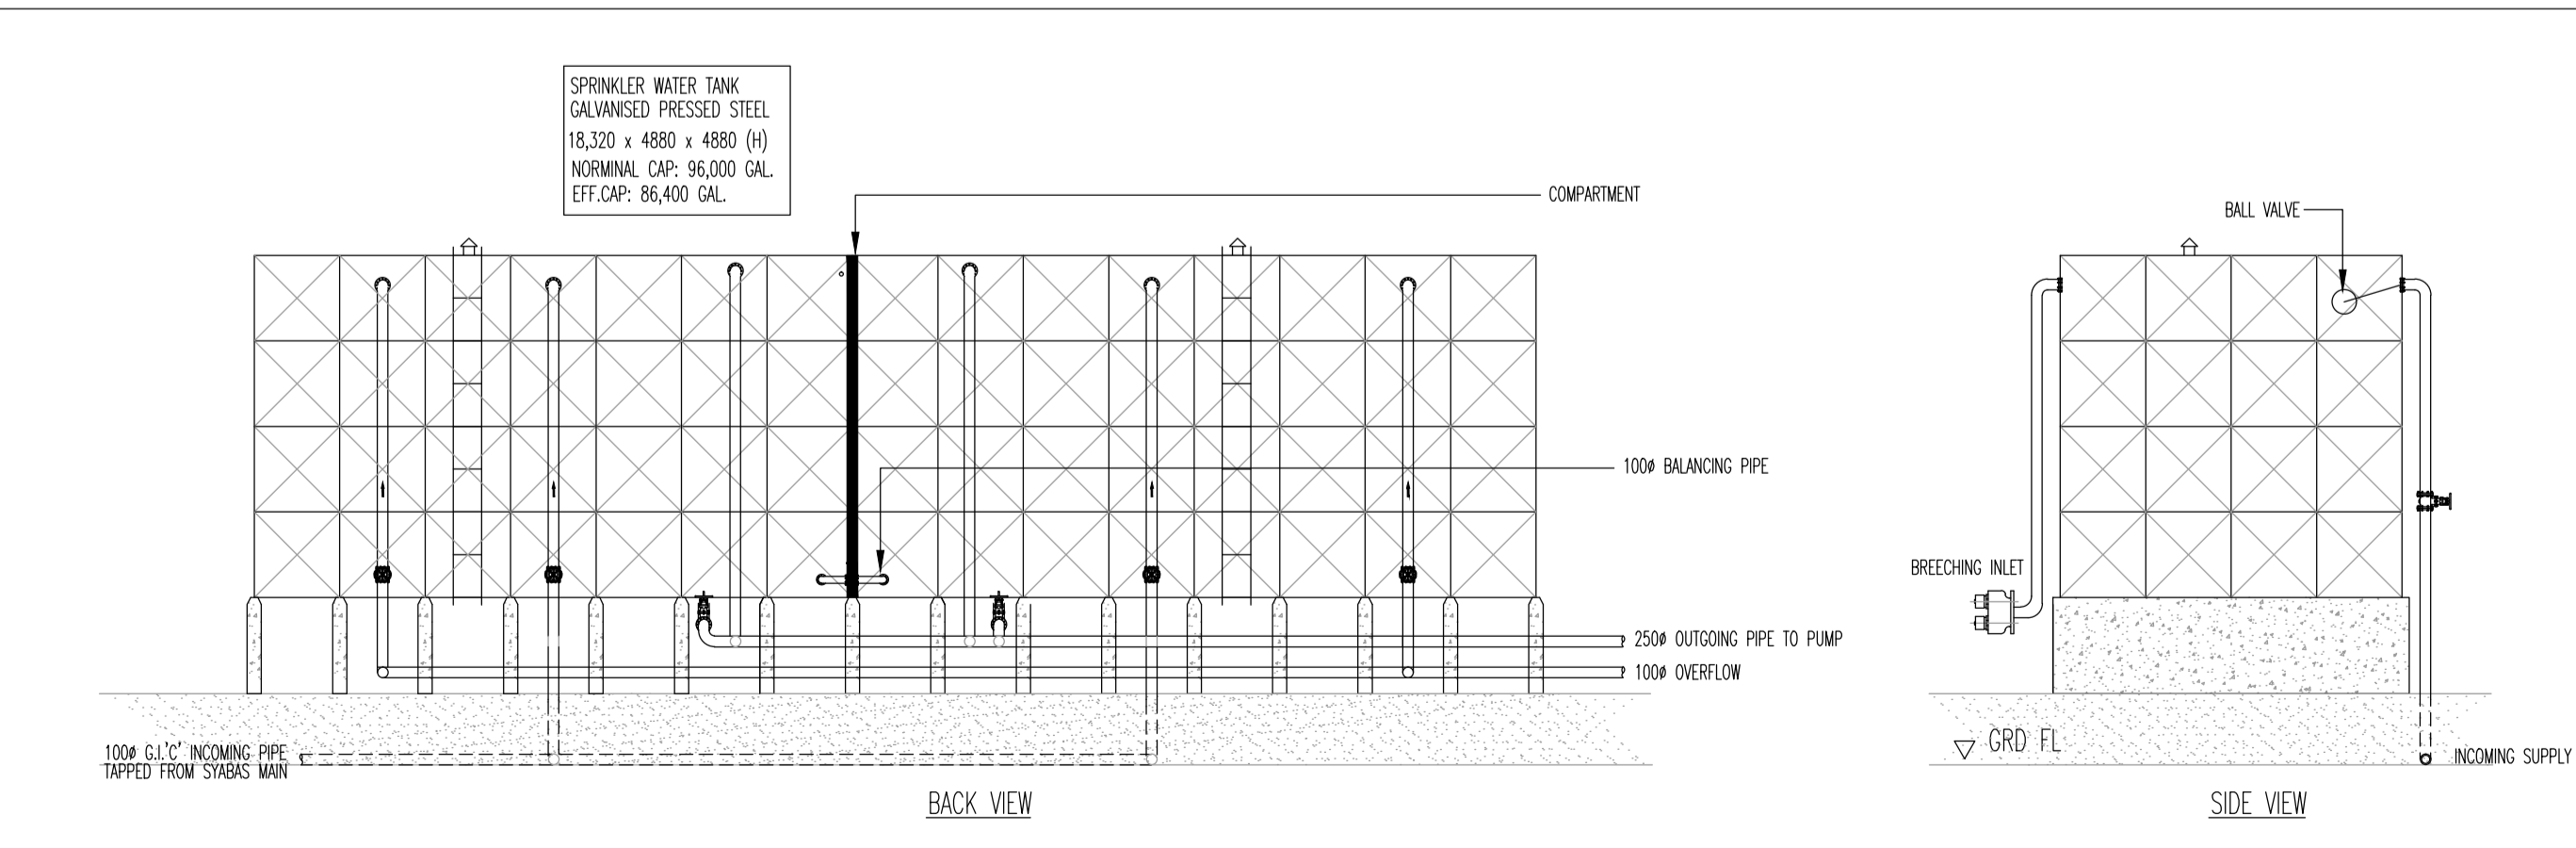

SPRINKLER TANK
SCALE : 1:100

TAJUK PROJEK :
**PERMOHONAN KEBENARAN MERANCANG
PENDIRIAN BANGUNAN BAGI CADANGAN
PEMBANGUNAN KILANG PENGELUARAN
KOMPONEN KAPAL TERBANG DI ATAS
SEBAGIAN LOT 1210, SEKSYEN U3, 40150
MUKIM DAMANSARA, DAERAH PETALING,
SELANGOR DARUL EHSAN.**

UNTUK TETUAN :
RHB TRUSTEES BERHAD
(As Trustee for Axis Real Estate Investment Trust)

PEMILIK TANAH :
MALAYSIA AIRPORTS HOLDING BERHAD
(MAHB) 48790-W
MALAYSIA AIRPORTS CORPORATE OFFICE,
PERSIARAN KORPORAT KLIA,
64000 KLIA, SELANGOR,
SELANGOR DARUL EHSAN
Tel: +603 8777 7000 Fax: +603 8777 7589

PEMILIK BANGUNAN :
RHB TRUSTEES BERHAD (873019-U)
(As Trustee for Axis Real Estate Investment Trust)
RHB Trustees Berhad
TINGKAT 11, TOWER ONE,
RHB CENTRE, JALAN TUN RAZAK,
50400 KUALA LUMPUR,
WILAYAH PERSEKUTUAN KUALA LUMPUR.
Tel: +603 9286 8799 Fax: +603 9286 8796

T.T ARKITEK :
KOOI KEAT ARCHITECT
no.19 taman bukit dumbar, 11600 penang, malaysia.
tel: 04-659 9987 fax: 04-656 8478 e-mail: kooikeat@kooikeatarchitect.com.my

**Ar. Ooi Kooi Keat
ARKITEK**
No. Pendaftaran LAM : A/O 61

MAIN CONTRACTOR :
AME CONSTRUCTION SDN BHD
NO 18 JALAN ANGKASA MAS 6,
KAWASAN PERINDUSTRIAN TEBRAU 2,
81100 JOHOR BAHRU, JOHOR.
TEL: 07-355 5111
FAX: 07-3541648

PERUNDING M & E :
HAN YANG CONSULTANCY SDN BHD
MECHANICAL & ELECTRICAL CONSULTING ENGINEERS
Tingkat 1, No. 19, Lorong Desa Pauh 1,
Taman Desa Pauh, 13700 Perai,
Pulau Pinang.
Tel: 04-39791100 Fax: 04-3979101
E-mail: hanyang.sdn.bhd@gmail.com

FIRE PROTECTION SYSTEM

DRAWING TITLE :
**DETAILS DRAWING NO.1
- PUMP ROOM
- WATER TANK**

SCALE : AS SHOWN
DATE : JANUARY 2019
DRAWING BY : FRANCIESE KANG
CHECK BY : STEVEN
DRAWING NO : 3445/NF/AAC/2018-DTL-1

AS-BUILT DRAWING