


FIRST FLOOR LEVEL (OVERALL PLAN)

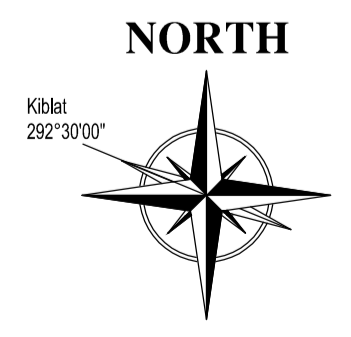

LEGEND FOR FIRE PROTECTION SYSTEM

ITEM	LEND	DESCRIPTION
1	○	UPRIFT SPRINKLER (HEAD/POINT)
2	●	POUNDER SPRINKLER (HEAD/POINT)
3	⊗	DOUBLE LINES SPRINKLER (HEAD/POINT)
4	⊗	CUT OFF SPRINKLER (HEAD/POINT)
5	⊗	FLOW SWITCH
6	⊗	STRETCH WIRE
7	⊗	SPRINKLER ALARM VALVE
8	⊗	GATE VALVE
9	⊗	MANUAL CALL POINT
10	⊗	FIRE ALARM BELL
11	⊗	2.27kg CARBON DIOXIDE PORTABLE FIRE EXTINGUISHER
12	⊗	8kg ABC DRY POWDER PORTABLE FIRE EXTINGUISHER
13	⊗	FUNCTION BOX
14	⊗	2.27kg CARBON DIOXIDE PORTABLE FIRE EXTINGUISHER
15	⊗	2.27kg CARBON DIOXIDE PORTABLE FIRE EXTINGUISHER
16	⊗	PUMP CONTROL PANEL (SPRINKLER)
17	⊗	FIRE ALARM CONTROL PANEL (MAGNETIC/ANALOGUE)
18	⊗	SPRINKLER PIPE RISER (ELECTRIC/LOCK)
19	⊗	EMERGENCY LIGHT
20	⊗	EMERGENCY LIGHT
21	⊗	MAN FIRE PUMPSET (DIESEL/STANDBY)
22	⊗	MAN FIRE PUMPSET (DIESEL/STANDBY)
23	⊗	Jockey PUMPSET (ELECTRIC/LOCK)
24	⊗	WATER TOWER
25	⊗	4-WAY BRIDGING ALERT C/FX NON RETURN CHECK VALVE

TAJUK PROJEK :
PERMOHONAN KEBERANAN MERANCANG
PENDIRIAN BANGUNAN BAGI CADANGAN
PEMBANGUNAN KILANG PENGELUARAN
KOMPONEN KAPAL TERBANG DI ATAS
SEBAHAGIAN LOT 1210, SEKSYEN U3, 40150
MUKIM DAMANSARA, DAERAH PETALING,
SELANGOR DARUL EHSAN.

UNTUK TETUAN :
RHB TRUSTEES BERHAD
(As Trustee for Axis Real Estate Investment Trust)

PEMILIK TANAH :
MALAYSIA AIRPORTS HOLDING BERHAD
(MAHB) (48792-W)
MALAYSIA AIRPORTS CORPORATION OFFICE,
PERSIDARAN KORPORAT KLIA,
64000 KLIA, SEPAANG,
SELANGOR DARUL EHSAN.
Tel: +603 8777 7000 Fax: +603 8777 7589

PEMILIK BANGUNAN :
RHB TRUSTEES BERHAD (573019-U)
(As Trustee for Axis Real Estate Investment Trust)
TINGKAT 11, TOWER ONE,
RHB CENTRE, JALAN TUN RAZAK,
60400 KUALA LUMPUR,
WILAYAH PERSEKUTUAN KUALA LUMPUR.
Tel: +603 9280 8799 Fax: +603 9280 8796

T.T ARKITEK :
KOOI KEAT ARCHITECT
no.19, Taman Bukit Dumar, 11600 penang, malaysia.
tel:04-659 9987 fax:04-656 8478 e-mail:kooikeat@kooikeatarchitect.com.my

Ar. Ooi Kooi Keat
ARKITEK
No. Pendaftaran LAM: A/0 61

MAIN CONTRACTOR :
AME CONSTRUCTION SDN BHD
NO 18 JALAN ANGKASA MAS 6,
KAWASAN PERINDUSTRIAN TEBRAU 2,
81100 JOHOR BAHRU, JOHOR.
TEL: 07- 355 5111
FAX: 07- 3541648

PERUNDING M & E :
HAN YANG CONSULTANCY SDN BHD
MECHANICAL & ELECTRICAL CONSULTING ENGINEERS
Tingkat 1, No. 19, Lorong Desa Pauh 1,
Taman Desa Pauh, 13700 Perai,
Pulau Pinang.
Tel: 04-3979100 Fax: 04-3979101
E-mail: hanyang.sdn.bhd@gmail.com

FIRE CONTRACTOR :
NATION FIRE ENGINEERING SDN BHD
(453143-D)
20, JALAN USJ 7/3A, UEP SUBANG JAYA,
47610 SUBANG JAYA, SELANGOR DARUL EHSAN.
TEL: 03-5621 0805/06 FAX: 03-5621 0815
E-MAIL: nationfire@yahoo.com

FIRE PROTECTION SYSTEM
TAJUK LUKISAN:
SPRINKLER SYSTEM
- 1ST FLOOR PLAN

SCALE : 1:300
DATE : JANUARY 2019
DRAWING BY : FRANCIESE KANG
CHEK BY : STEVEN
DRAWING NO : 3445/NF/AAC/2018-FF02

AS-BUILT DRAWING