


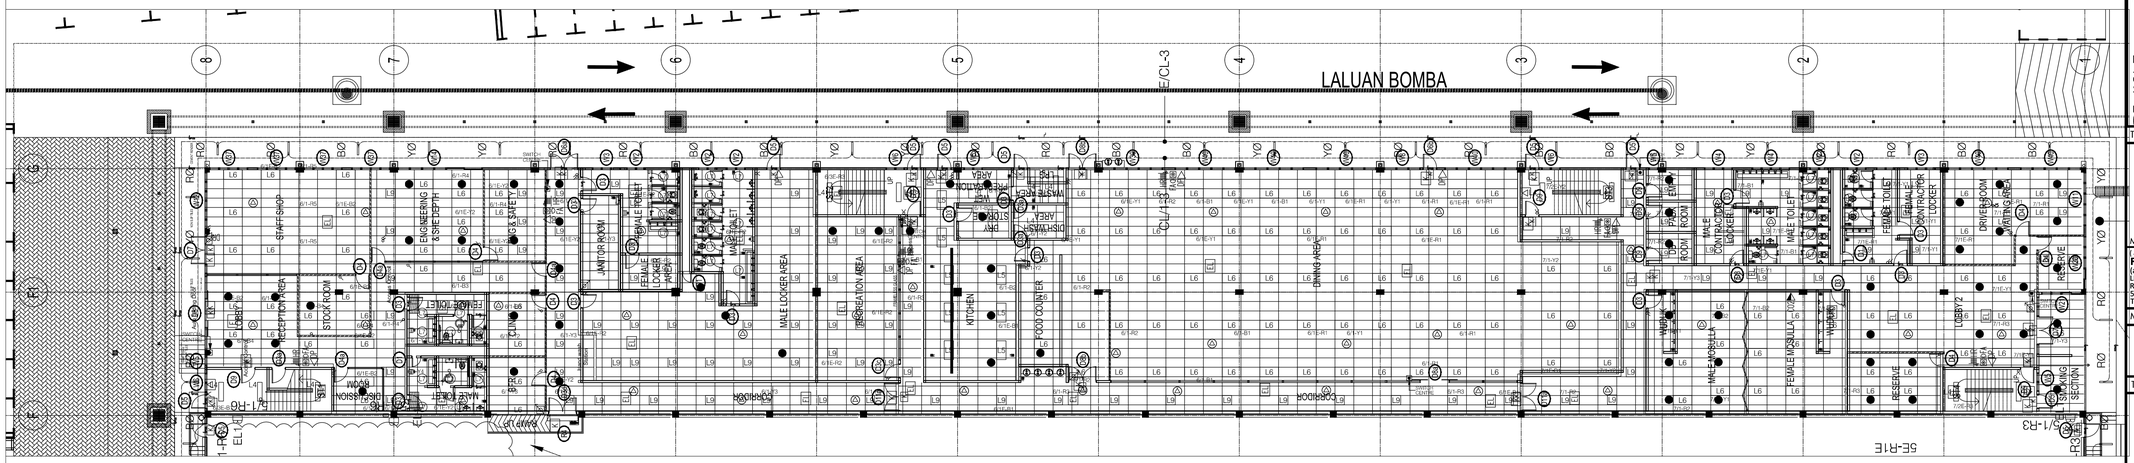


# AS-BUILT DRAWING

TAJUK PROJEK

KERLULUSAN PELAN BANGUNAN BAGI :
CADANGAN PEMBANGUNAN MEMBINA GUDANG
MERANGKUMI :-
1. FASA 1 - GUDANG 1 TINGKAT ( 120m X 360m )
DENGAN PEJABAT / BLOK SOSIAL
2 TINGKAT SERTA SEBUAH PENCAWANG
ELEKTRIK DAN SERAH SEBAHAGIAN
TANAH DIBAWAH SEKSYEN 200 KTN
UNTUK KOLAM TAKUNGAN ( 2.414 ekar )
DIATAS LOT 7316 ( P.T. 3609 )
JALAN KLANG - BANTING, MUKIM TELUK PANGLIMA
GARANG, DAERAH KUALA LANGAT,
SELANGOR DARUL EHSAN.

UNTUK TETUAN : RHB TRUSTEES BERHAD.
(AS TRUSTEE FOR AXIS REAL ESTATE INVESTMENT TRUST )

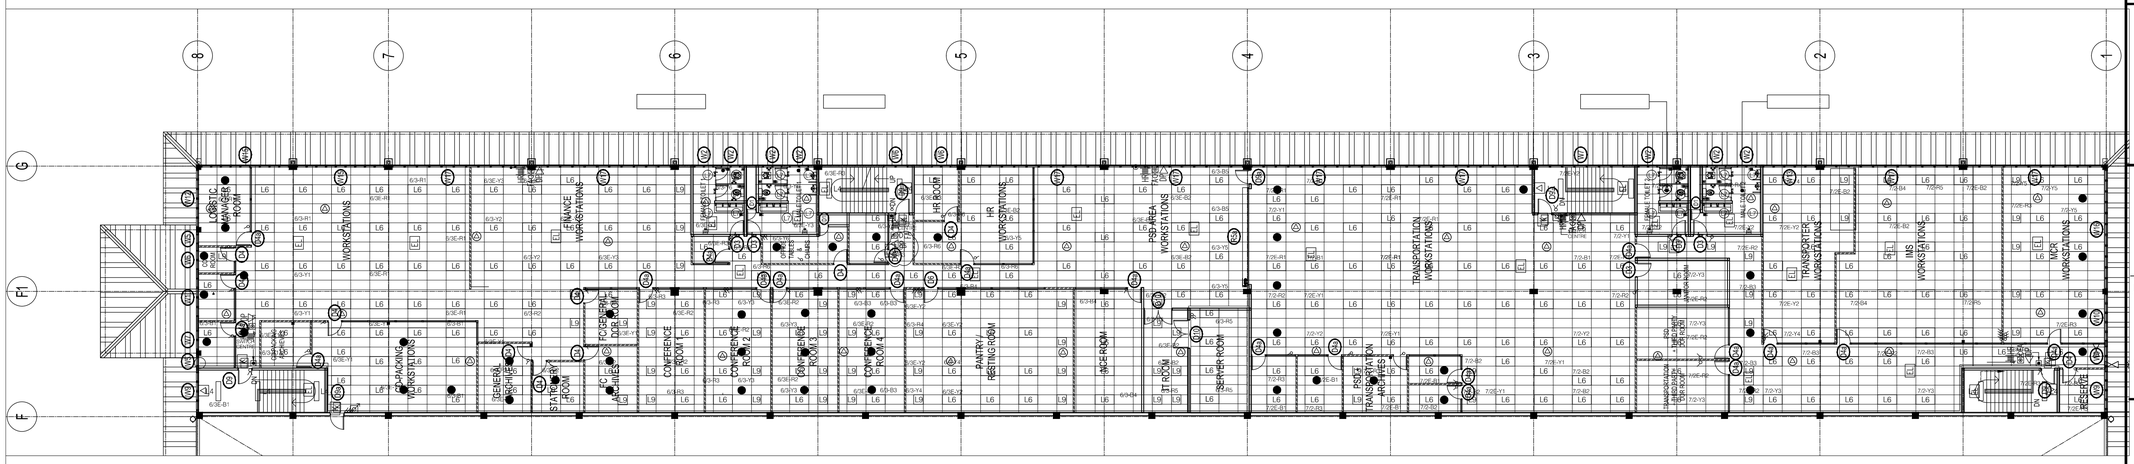TANDATANGAN PEMAJU

MR. TONY CHIENG SIONG UNG NO K.P : 730508-13-5227
( JAWATAN : PENGARAH URUSAN )
**RHB TRUSTEES BERHAD (673019-U)**
(as trustee for AXIS-REIT)
LEVEL 11, TOWER ONE,
RHB CENTRE , JALAN TUN RAZAK,
50400 KUALA LUMPUR, MALAYSIA.
TEL:- +603-9280 8799 FAX :- +603-9280 8796

MAKLUMAT ARKITEK

TANDATANGAN ARKITEK

LEMBAGA ARKITEK MALAYSIA

OOI KOOI KEAT K/P: 720817-07-5361
AR. OOI KOOI KEAT
ARKITEK PROFESIONAL
No. Pendaftaran LAM : A/O 61
K O O I K E A T A R C H I T E C T
no.19, taman bukit dumbar, 11600 penang, malaysia.
tel : 04 - 659 9987 fax : 04 - 656 8478 e-mail : k e a t a r c h @ g m a i l . c o m
* SAYA MEMPERAKUI BAHAWA BUTIRAN-BUTIRAN DALAM PELAN-PELAN ADALAH MENURUT KEHENDAK-KEHENDAK UNDANG-UNDANG KECIL BANGUNAN SERAGAM SELANGOR 1986 DAN SAYA SETUJU TERIMA TANGGUNG JAWAB PENUH DENGAN SEWAJARNYA.*

TANDATANGAN JURUTERA MEKANIKAL & ELEKTRIKAL

HAN YANG CONSULTANCY SDN BHD
MECHANICAL & ELECTRICAL CONSULTING ENGINEERS
12-B, Medan Angsana 2,
11500 Bandar Baru Ayer Itam,
Pulau Pinang.
Tel: 04-8294489 Fax: 04-8292289
E-mail : hanyang.sdn.bhd@gmail.com

MAIN CONTRACTOR :

AME CONSTRUCTION SDN BHD

NO 18 JALAN ANGKASA MAS 6,
KAWASAN PERINDUSTRIAN TEBRAU 2,
81100 JOHOR BAHRU,JOHOR.

TEL: 07- 355 5111
FAX: 07- 3541648

ELECTRICAL CONTRACTOR

Kejuruteraan Broad-Way Sdn. Bhd.

NO.29, JALAN JINTAN, TEL: 03-91317672
TAMAN SUPREME, CHERAS, FAX: 03-91319735
56100, KUALA LUMPUR. EMAIL: k_broadway_sb@yahoo.com

**LEGEND - ELECTRICAL & PA**

LEGEND : ELECTRICAL INSTALLATION

**NORMAL SUPPLY**

- L4 — 40W. LED DIFFUSED BATTEN LUMINAIRE SURFACE MOUNTED.
- L5 — 38W. LED IP65 LUMINAIRE C/W. POLYCARBONATE OPAL DIFFUSER AND STAINLESS STEEL CLIPS.
- L6 — 38W. LED RECESS LUMINAIRE C/W. PMMA DIFFUSER ( 600 X 1200mm )
- L7 — 13W LED RECESS DOWNLIGHT IP54 C/W OPAL DIFFUSER.
- L9 — 38W. LED RECESS LUMINAIRE C/W PMMA DIFFUSER. (600 x 600mm)
- EL — 1.8W LED SELF-CONTAINED EMERGENCY LIGHT C/W. 3 HOURS RATING NICKLE CADMIUM BATTERY & CHARGER.
- K — 1.8W LED SELF-CONTAINED KELUAR LIGHT C/W. 3 HOURS RATING NICKLE CADMIUM BATTERY & CHARGER.
- 10A. SP ONE WAY RECESS MOUNTED SWITCH.
- 10A. SP TWO WAY RECESS MOUNTED SWITCH.
- 10A. SP SWITCH CENTRE.

**ESSENTIAL SUPPLY**

- L4 — 40W. LED DIFFUSED BATTEN LUMINAIRE SURFACE MOUNTED.
- L5 — 38W. LED IP65 LUMINAIRE C/W. POLYCARBONATE OPAL DIFFUSER AND STAINLESS STEEL CLIPS.
- L6 — 38W. LED RECESS LUMINAIRE C/W. PMMA DIFFUSER ( 600 X 1200mm )
- L7 — 13W LED RECESS DOWNLIGHT IP54 C/W OPAL DIFFUSER.
- L9 — 38W. LED RECESS LUMINAIRE C/W PMMA DIFFUSER. (600 x 600mm)

LEGEND : EXTERNAL LOW VOLTAGE

PUBLIC ADDRESS

- 6W CEILING SPEAKER RECESS MOUNTED C/W MATCHING TRANSFORMER TAP AT 1W
- 6W BOX SPEAKER RECESS MOUNTED C/W MATCHING TRANSFORMER TAP AT 1W
- 15W HORN SPEAKER MOUNTED AT 13m HEIGHT C/W MATCHING TRANSFORMER TAP AT 5W
- 6W BOX SPEAKER SURFACE MOUNTED C/W MATCHING TRANSFORMER TAP AT 1W
- VOLUME CONTROL C/W OVERIDING RELAY

TAJUK KECIL LUKISAN :

OFFICE
- LIGHTING LAYOUT
- LEGEND

This drawing is copyright of KOOI KEAT ARCHITECT.
All Rights Reserved

| | | | |
|---|---|---|---|
| Disemak oleh | | | |
| Diluluskan oleh | CHAN | | |
| Skala | | | |
| Revision | 00 | | |
| Tarikh | DEC 2017 | | |

| NO. RUJUKAN | NO. LUK. |
|---|---|
| KBSB/SEL-16424-OFF-E | 02 |