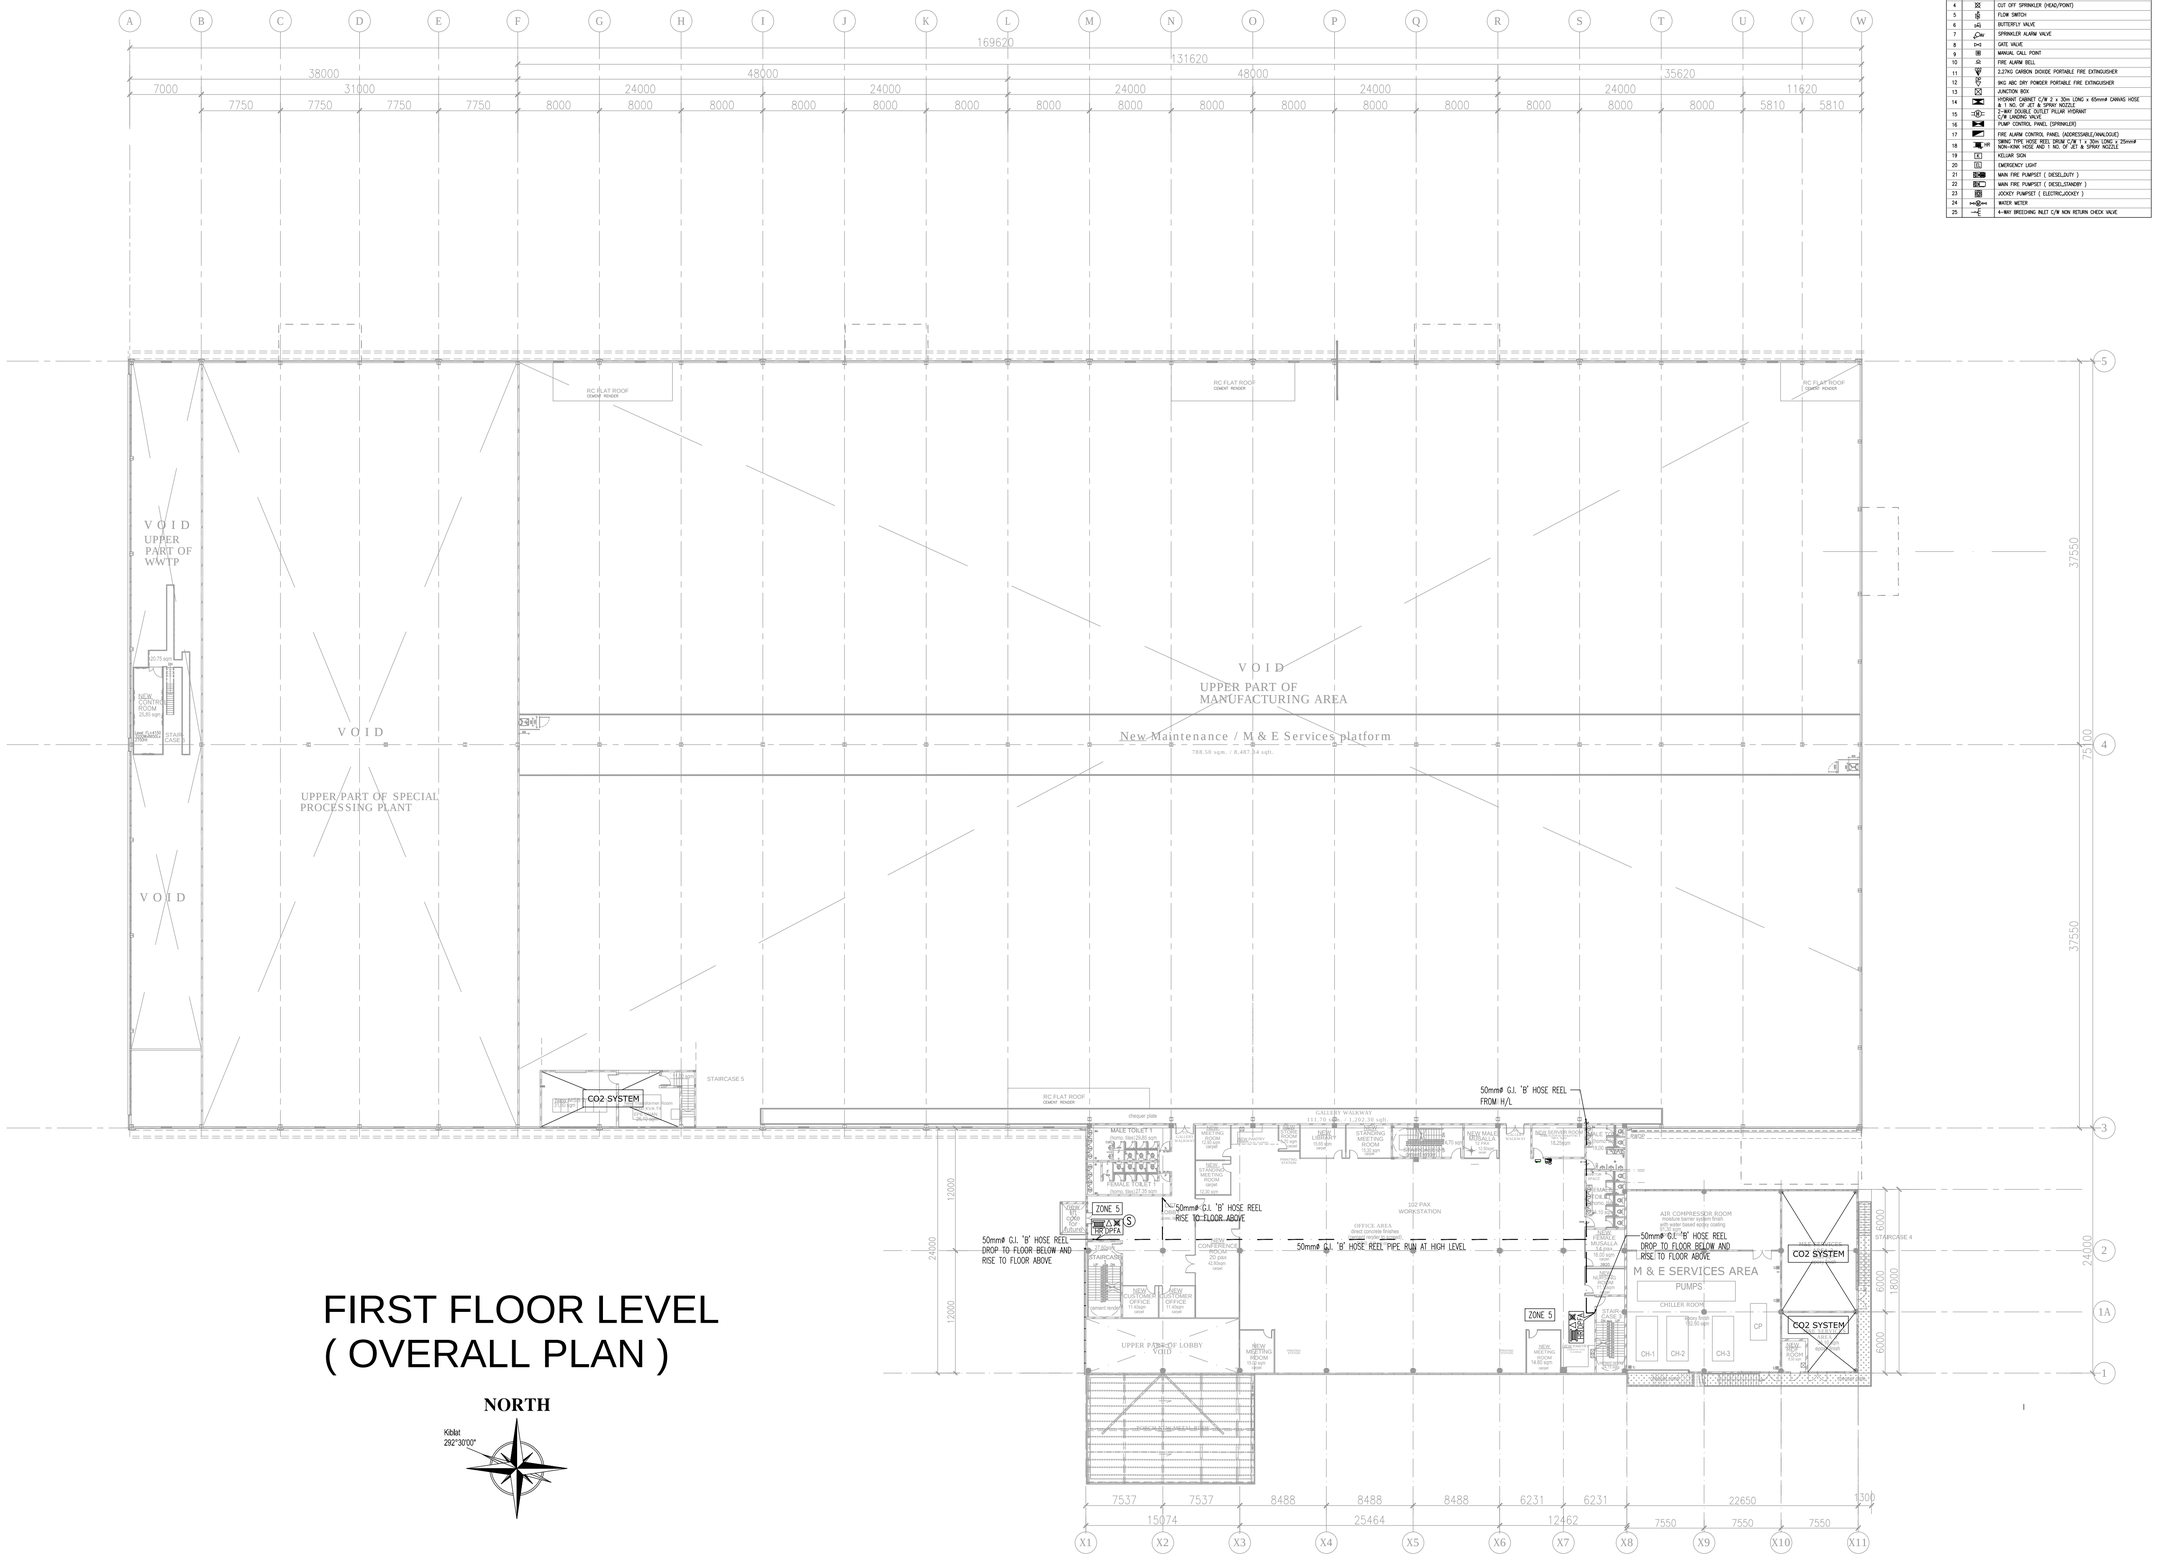

FIRST FLOOR LEVEL
(OVERALL PLAN)

NORTH

Kiblat
292°30'00"

AS-BUILT DRAWING

LEGEND FOR FIRE PROTECTION SYSTEM

ITEM	LEGEND	DESCRIPTION
1		UPRIGHT SPRINKLER (HEAD/POINT)
2		PENDENT SPRINKLER (HEAD/POINT)
3		DOUBLE LAYER SPRINKLER (HEAD/POINT)
4		CUT OFF SPRINKLER (HEAD/POINT)
5		FLOW SWITCH
6		BUTTERFLY VALVE
7		SPRINKLER ALARM VALVE
8		GATE VALVE
9		MANUAL CALL POINT
10		FIRE ALARM BELL
11		2.27KG CARBON DIOXIDE PORTABLE FIRE EXTINGUISHER
12		9KG ABC DRY POWDER PORTABLE FIRE EXTINGUISHER
13		JUNCTION BOX
14		HYDRANT CABINET C/W 2 x 30m LONG x 65mmø CANVAS HOSE & 1 NO. OF JET & SPRAY NOZZLE
15		2-WAY DOUBLE OUTLET PILLAR HYDRANT C/W 2 HOSING VALVE
16		PUMP CONTROL PANEL (SPRINKLER)
17		FIRE ALARM CONTROL PANEL (ADDRESSABLE/ANALOGUE)
18	HR	SWING TYPE HOSE REEL DRUM C/W 1 x 30m LONG x 25mmø NON-KINK HOSE AND 1 NO. OF JET & SPRAY NOZZLE
19		KELUAR SIGN
20		EMERGENCY LIGHT
21		MAIN FIRE PUMPSET (DIESEL,DUTY)
22		MAIN FIRE PUMPSET (DIESEL,STANDBY)
23		JOCKEY PUMPSET (ELECTRIC,JOCKEY)
24		WATER METER
25		4-WAY BREECHING INLET C/W NON RETURN CHECK VALVE

TAJUK PROJEK :

PERMOHONAN KEBENARAN MERANCANG PENDIRIAN BANGUNAN BAGI CADANGAN PEMBANGUNAN KILANG PENGELUARAN KOMPONEN KAPAL TERBANG DI ATAS SEBAHAGIAN LOT 1210, SEKSYEN U3, 40150 MUKIM DAMANSARA, DAERAH PETALING, SELANGOR DARUL EHSAN.

UNTUK TETUAN :
RHB TRUSTEES BERHAD
(As Trustee for Axis Real Estate Investment Trust)

PEMILIK TANAH :

MALAYSIA AIRPORTS HOLDING BERHAD (MAHB) (487092-W)
MALAYSIA AIRPORTS CORPORATE OFFICE,
PERSIARAN KORPORAT KLIA,
64000 KLIA, SEPANG,
SELANGOR DARUL EHSAN
Tel: +603 8777 7000 Fax: +603 8777 7589

PEMILIK BANGUNAN :

RHB TRUSTEES BERHAD (973019-U)
(As Trustee for Axis Real Estate Investment Trust)
TINGKAT 11, TOWER ONE,
RHB CENTRE, JALAN TUN RAZAK,
50400 KUALA LUMPUR,
WILAYAH PERSEKUTUAN KUALA LUMPUR.
Tel: +603 9280 8799 Fax: +603 9280 8796

T.T ARKITEK :

[redacted] KOO I KEAT ARCHITECT
no.19, taman bukit dumbar, 11600 penang, malaysia.
tel : 04 - 659 9987 fax : 04 - 656 8478 e-mail : kooikeat @ kooikeatarchitect.com.my

LEMBAGA ARKITEK MALAYSIA

Ar. Ooi Kooi Keat
ARKITEK
No. Pendaftaran LAM : A/O 61

MAIN CONTRACTOR :

AME CONSTRUCTION SDN BHD
NO 18 JALAN ANGKASA MAS 6,
KAWASAN PERINDUSTRIAN TEBRAU 2,
81100 JOHOR BAHRU,JOHOR.
TEL: 07- 355 5111
FAX: 07- 3541648

PERUNDING M & E :

HAN YANG CONSULTANCY SDN BHD
MECHANICAL & ELECTRICAL CONSULTING ENGINEERS
Tingkat 1, No. 19, Lorong Desa Pauh 1,
Taman Desa Pauh, 13700 Perai,
Pulau Pinang.
Tel: 04-3979100 Fax: 04-3979101
E-mail : hanyang.sdn.bhd@gmail.com

FIRE CONTRACTOR :

NATION FIRE ENGINEERING SDN BHD
(453143-D)
20, JALAN USJ 7/3A, UEP SUBANG JAYA,
47610 SUBANG JAYA, SELANGOR DARUL EHSAN.
TEL: 03-5621 0805/06 FAX: 03-5621 0815
E-MAIL: nationfire@yahoo.com

FIRE PROTECTION SYSTEM

TAJUK LUKISAN:

HOSE REEL & FIRE ALARM SYSTEM
- 1ST FLOOR PLAN

SCALE :	1:300
DATE :	JANUARY 2019
DRAWING BY :	FRANCIESE KANG
CHEK BY :	STEVEN
DRAWING NO :	3445/NF/AAC/2018-FF06